

PIKE  
L 25  
3-10-69

MISSISSIPPI  
BOARD OF WATER COMMISSIONERS  
416 North State Street  
Jackson, Mississippi 39201

WATER WELL DRILLERS LOG

INDEXED

Mar. 10 1969 J.T. Cunningham & Son Pike  
date well completed firm name county well located

LANDOWNER: Otis Simmons

description of formations encountered	from	to
2 1/2' Sand & Rocks	0	2 1/2'

Mpna l.p. Miss  
(mailing address)

WELL LOCATION:

sec. 8 T 1 N R 8 E  
S S W  
10.5 miles S.E. of Magnolia  
(distance) (direction) (nearest town)

WELL PURPOSE: Home  
(home, irrigation, municipal, industrial)

WELL COMPLETION DATA:

- (1) diameter (inches) 4"
- (2) total depth (feet) 100'
- (3) static water level (feet) 65' below top of ground.
- (4) casing Plastic 94'  
(material) (depth)  
(size) if telescope see back.
- (5) screen 6' 100'  
(length) (depth to top)  
4" Plastic  
(size) (material)
- (6) pump 1/2 8  
(HP) (yield gpm)  
A.C.  
(type power)
- (7) electric log (yes or no)
- (organization running log)
- (8) how well bottom plugged wood

INDEXED


MAR 20 1969

MISS. DE. OF WATER RESOURCES

DRILLERS REMARKS:

If well telescopes please sketch and show depths.

GROUND LEVEL

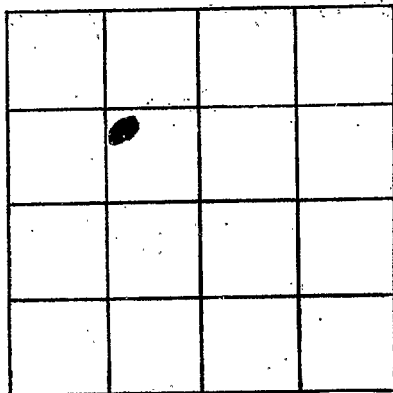

SECTION 8

Please indicate well location X.

ADDITIONAL INFORMATION

If more than one screen, show locations of each on sketch.