

CODED
 Pike
 L 26
 12-68

MISSISSIPPI
 BOARD OF WATER COMMISSIONERS
 416 North State Street
 Jackson, Mississippi 39201

CODED

WATER WELL DRILLERS LOG

Dec 13 1968 date well completed
 R. E. Keener & Son, Inc. firm name
 Pike county well located

LANDOWNER: Odie Brown
 R. E. Magnolia
 (mailing address)

| description of formations encountered | from | to |
|---------------------------------------|------|----|
| Red sandy clay | 0 | 17 |
| Red sand | 17 | 52 |
| Gravel | 52 | 58 |
| Red chert | 58 | 67 |
| Coarse sand & pea gravel | 67 | 79 |

WELL LOCATION:
 sec. 9 T. 1 N. R. 4 E
 10 miles SE of Magnolia
 (distance) (direction) (nearest town)

WELL PURPOSE: Drain
 (home, irrigation, municipal, industrial)

WELL COMPLETION DATA:

- (1) diameter (inches) 4"
- (2) total depth (feet) 77
- (3) static water level (feet) 55 below top of ground.
- (4) casing Plastics bottom
 (material) (depth)
 (size) if telescope see back.
- (5) screen 6' 71"
 (length) (depth to top)
4" Plastics
 (size) (material)
- (6) pump 1/2 Sub - 12
 (HP) (yield gpm)
Elect
 (type power)
- (7) electric log No
 (yes or no)

(organization running log)

(8) how well bottom plugged
wooden plug

DRILLERS REMARKS:
No Pellets well


CODED

MAR 27 1969

MISS. Bd. of WATER COMMISSIONERS

If well telescopes please sketch and show depths.

GROUND LEVEL

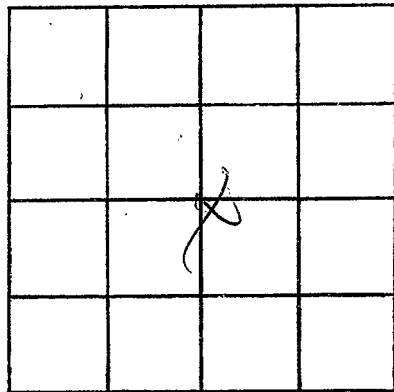

SECTION 9

Please indicate well location X.

ADDITIONAL INFORMATION

If more than one screen, show locations of each on sketch.