

**MISSISSIPPI
BOARD OF WATER COMMISSIONERS**
416 North State Street
Jackson, Mississippi 39201

CODED

Pike
L27
2-10-69

WATER WELL DRILLERS LOG

Feb-10 date well completed 69 Revere Well Drilling Co. firm name Pike county well located

LANDOWNER: Donald Knight
H. N. Osyka
(mailing address)

description of formations encountered	from	to
Red clay	0	17
Red sand	17	72
gravel, chert & sand	72	100
Diagravel sand	100	110

WELL LOCATION:
sec 23 T 1 N R 8 E
2 1/2 miles W of Poplar
(distance) (direction) (nearest town)

WELL PURPOSE: Home
(home, irrigation, municipal, industrial)

- WELL COMPLETION DATA:
- (1) diameter (inches) 4"
 - (2) total depth (feet) 110'
 - (3) static water level (feet) 70 below top of ground.
 - (4) casing Plastic bottom
(material) (depth)
 - (size) if telescope see back.
 - (5) screen 6' 104'
(length) (depth to top)
 - 4" Plastic
(size) (material)
 - (6) pump 1/2 hp 6
(HP) (yield gpm)
 - Electric
(type power)
 - (7) electric log
(year-no)
 - (organization running log)

(8) how well bottom plugged
wooden plug


DRILLERS REMARKS:
New location

APR 24 1969

MISS. BD. OF
WATER COM.

If well telescopes please sketch and show depths.

GROUND LEVEL

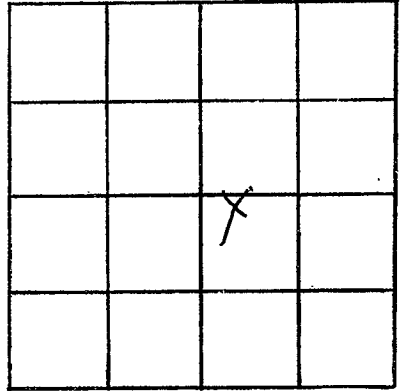

SECTION 23

Please indicate well location X.

ADDITIONAL INFORMATION

If more than one screen, show locations of each on sketch.