

Pike  
L 28  
6-69

MISSISSIPPI  
BOARD OF WATER COMMISSIONERS  
416 North State Street  
Jackson, Mississippi 39201

CODED

WATER WELL DRILLERS LOG

6-17 1969 *Fitzgerald Well Serv* *Pike*  
date well completed firm name county well located


LANDOWNER:	description of formations encountered	from	to
Howard Smith	Red Clay	0	15
R.R. Magnolia Miss. (mailing address)	Red Sand	15	60
WELL LOCATION: sec. 12 T 1 N R 8 E S W	Red gravel	60	90
8 miles SE of Magnolia (distance) (direction) (nearest town)	Coarse Sand & gravel	90	123
WELL PURPOSE: Home (home, irrigation, municipal, industrial)			
WELL COMPLETION DATA: (1) diameter (inches) 4			
(2) total depth (feet) 123			
(3) static water level (feet) 100 below top of ground.			
(4) casing <u>Plastic</u> 117 (material) (depth)			
4 if telescope see back. (size)			
(5) screen 6 117 (length) (depth to top)			
4 plastic (size) (material)			
(6) pump 7 7 (HP) (yield gpm)			
Gelco (type power)			
(7) electric log <u>no</u> (yes or no)			
(organization running log)			
(8) how well bottom plugged <u>wood peg</u>			
DRILLERS REMARKS:			

CODED

APR 4 1969  
MISS. RD. DEPT.  
WATER CONTROL

If well telescopes please sketch and show depths.

GROUND LEVEL

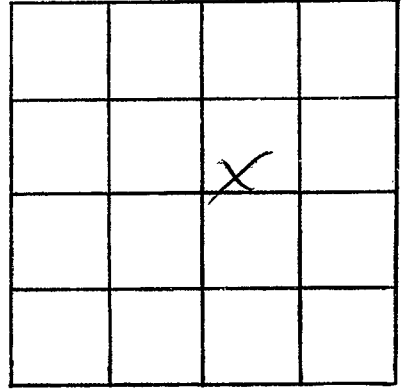

SECTION 13

Please indicate well location X.

ADDITIONAL INFORMATION

If more than one screen,  
show locations of each on sketch.