

Pike Co
 L 29
 3-6-70

MISSISSIPPI
 BOARD OF WATER COMMISSIONERS
 416 North State Street
 Jackson, Mississippi 39201

CODED

WATER WELL DRILLERS LOG

3-6 1970 Fitzgerald Well Serv Pike
 date well completed firm name county well located

LANDOWNER:
Clifton Simmons
RR 1 Delta, Miss.
 (mailing address)

description of formations encountered	from	to
Red clay	0	20
Red sand	20	60
Red gravel	60	95
Red sand	95	105
Coarse sand & gravel	105	118

WELL LOCATION:
 sec. 30 T 1 N R 3 E
5 miles NNE of OSYKA
 (distance) (direction) (nearest town)

WELL PURPOSE: Home
 (home, irrigation, municipal, industrial)

- WELL COMPLETION DATA:
- (1) diameter (inches) 4
 - (2) total depth (feet) 118
 - (3) static water level (feet) 65 below above top of ground.
 - (4) casing Plastic 110
 (material) (depth)
4 if telescope see back.
 (size)
 - (5) screen 8 110
 (length) (depth to top)
4 Plastic
 (size) (material)
 - (6) pump 1/2 10
 (HP) (yield gpm)
Elc
 (type power)
 - (7) electric log no
 (yes or no)
 (organization running log)
 - (8) how well bottom plugged Good log

CODED


MAR 16 1970

MISS. BD. OF
 WATER COMM.

DRILLERS REMARKS:

If well telescopes please sketch and show depths.

GROUND LEVEL

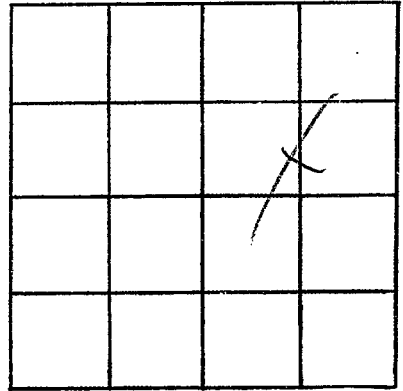

SECTION 20

Please indicate well location X.

ADDITIONAL INFORMATION

If more than one screen,
show locations of each on sketch.