

Pike
L 32
6-27-70

MISSISSIPPI
BOARD OF WATER COMMISSIONERS
416 North State Street
Jackson, Mississippi 39201

CODED

WATER WELL DRILLERS LOG

June 27 1970 Chesterkemes Pike
date well completed firm name county well located

LANDOWNER: F. Taylor
RFD 1
Oxyba
(mailing address)

description of formations encountered	from	to
clay	0	4
white chalk	4	13
pink chalk	13	40
red sand gravel	40	70
striped sand shell	70	106
red gravel sand	106	117

WELL LOCATION:
sec. 24 T. 1 N. R. 8 E
1 1/4 miles SW of Progers
(distance) (direction) (nearest town)

WELL PURPOSE: House
(home, irrigation, municipal, industrial)

- WELL COMPLETION DATA:
- (1) diameter (inches) 4"
 - (2) total depth (feet) 117
 - (3) static water level (feet) 68 Below top of ground.
 - (4) casing cast iron (material) Bottom (depth)
 - (size) If telescope see back.
 - (5) screen 10 (length) 111 (depth to top)
 - 4" (size) plastic (material)
 - (6) pump 1/2 sub (HP) 12 (yield gpm)
 - blow (type power)
 - (7) electric log No (yes or no)
 - (organization running log)

CODED

(8) how well bottom plugged? wood plug


DRILLERS REMARKS:
New location

JUL 27 1970

MISS. BD. OF
WATER COM.

If well telescopes please sketch and show depths.

GROUND LEVEL

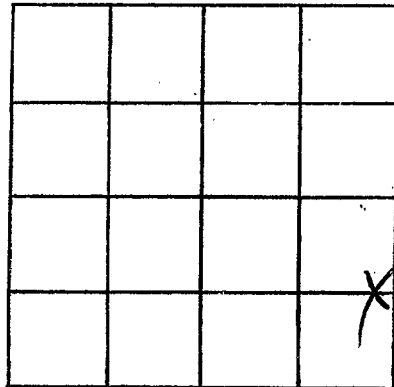

SECTION 24

Please indicate well location X.

ADDITIONAL INFORMATION

If more than one screen,
show locations of each on sketch.