

PIKE
L33
3-23-70

MISSISSIPPI
BOARD OF WATER COMMISSIONERS
416 North State Street
Jackson, Mississippi 39201

CODED

WATER WELL DRILLERS LOG

March 23 1970 Reverswell Pump Co. Pike
date well completed firm name county well located

LANDOWNER: Albert L. Lavelle
Pt. 1, Osyka

description of formations encountered	from	to
Clay	0	12
Sand & Gravel	12	43
Red Chalk	43	92
Small gravel Sand	92	102

(mailing address)

WELL LOCATION:
sec 22 T. 14 N. R. 8 E
5 miles ENE of Osyka
(distance) (direction) (nearest town)

WELL PURPOSE: Home Water
(home, irrigation, municipal, industrial)

WELL COMPLETION DATA:

- (1) diameter (inches) 4"
- (2) total depth (feet) 102
- (3) static water level (feet) 46 below top of ground.
- (4) casing Plastic Bottom
(material) (depth)
- (size) if telescope see back.
- (5) screen 6' 96'
(length) (depth to top)
- 1 1/2" Plastic
(size) (material)
- (6) pump Franchel
(HP) (yield gpm)
installed by owner
(type power)
- (7) electric log No
(yes or no)

CODED

(organization running log)

(8) how well bottom plugged
wooden plug


OCT 14 1970

DRILLERS REMARKS:

MISS. BD. OF
WATER

If well telescopes please sketch and show depths.

GROUND LEVEL

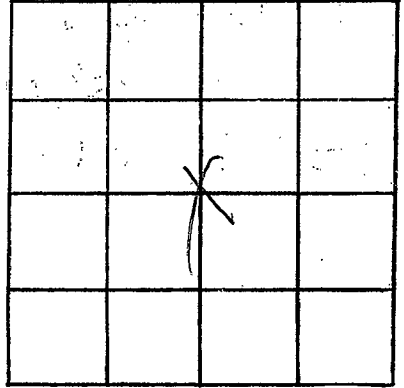

SECTION 27

Please indicate well location X.

ADDITIONAL INFORMATION

If more than one screen,
show locations of each on sketch.