

PIKE
L34
8-4-70

MISSISSIPPI
BOARD OF WATER COMMISSIONERS
416 North State Street
Jackson, Mississippi 39201

CODED

WATER WELL DRILLERS LOG

Aug 4 1970 Chet Deane Pike
date well completed firm name county well located

LANDOWNER: Nathaniel Magel
Rt 1, Osyka
(mailing address)

WELL LOCATION:
sec. 35 T 1 N R 8 E
5 1/2 miles E Osyka
(distance) (direction) (nearest town)

WELL PURPOSE: Home
(home, irrigation, municipal, industrial)

WELL COMPLETION DATA:
(1) diameter (inches) 4"
(2) total depth (feet) 121'
(3) static water level (feet) 97 below above top of ground.
(4) casing Plastic bottom
(material) (depth)

(size) if telescope see back.

(5) screen 6' 115'
(length) (depth to top)
1 1/2" Plastic
(size) (material)

(6) pump 3/4 hp 8
(HP) (yield gpm)
Electric
(type power)

(7) electric log no
(yes or no)
(organization running log)

(8) how well bottom plugged
wooden plug

DRILLERS REMARKS:
New well

description of formations encountered	from	to
<u>Red clay</u>	<u>0</u>	<u>15</u>
<u>Red sand</u>	<u>15</u>	<u>80</u>
<u>Sand & gravel</u>	<u>80</u>	<u>96</u>
<u>pink chalk</u>	<u>96</u>	<u>101</u>
<u>chalk & gravel</u>	<u>101</u>	<u>110</u>
<u>Sand & gravel</u>	<u>110</u>	<u>121</u>


CODED

OCT 14 1970

MISS. BD. OF
WATER COMMISSIONERS

If well telescopes please sketch and show depths.

GROUND LEVEL

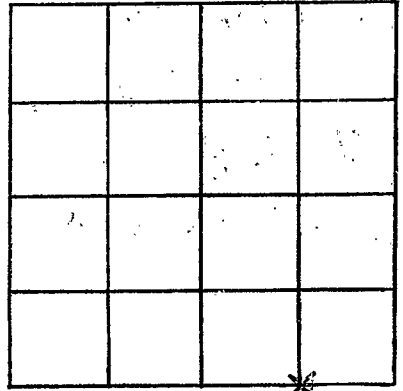

SECTION 35

Please indicate well location X.

ADDITIONAL INFORMATION

If more than one screen,
show locations of each on sketch.