

PIKE
L 36
9-17-70

MISSISSIPPI
BOARD OF WATER COMMISSIONERS
416 North State Street
Jackson, Mississippi 39201

CODED

WATER WELL DRILLERS LOG

Sept 17 1970 J. T. Colington & Son Pike
date well completed firm name county well located

LANDOWNER:
Smith Warren
Progress, Miss.
(mailing address)

description of formations encountered	from	to
Clay	0	20
Chalk	30	60
Sand	60	90
Sand + Gravel	90	127

WELL LOCATION:
sec. 5 T. 1 N R. 8 E
6 miles $\frac{3}{2}$ of Progress
(distance) (direction) (nearest town)

WELL PURPOSE: Home
(home, irrigation, municipal, industrial)

- WELL COMPLETION DATA:
- (1) diameter (inches) 4"
 - (2) total depth (feet) 127'
 - (3) static water level (feet) 90 below above top of ground.
 - (4) casing (material) (depth) (size) If telescope see back.
 - (5) screen (length) (depth to top) (size) (material)
 - (6) pump (HP) (yield gpm) (type power)
 - (7) electric log (yes or no)
 - (organization running log)
 - (8) how well bottom plugged wood

CODED


DEC 11 1970

DRILLERS REMARKS:

MISS. BD. OF
WATER COMM.

If well telescopes please sketch and show depths.

GROUND LEVEL

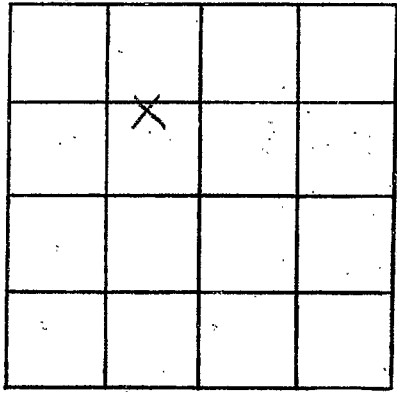

SECTION 5

Please indicate well location X.

ADDITIONAL INFORMATION

A series of horizontal lines for writing additional information, starting below the 'ADDITIONAL INFORMATION' header and extending to the bottom of the page.

If more than one screen, show locations of each on sketch.