

PIKE
L37
12-14-70

MISSISSIPPI
BOARD OF WATER COMMISSIONERS
416 North State Street
Jackson, Mississippi 39201

CODED

WATER WELL DRILLERS LOG

12-14 1970 *F. G. Wells* *Pike*
date well completed firm name county well located

LANDOWNER:	description of formations encountered	from	to
<i>Alvie Strickland</i>			
<i>R.B. Magnolia Drive</i> (mailing address)	<i>Red clay</i> <i>Red sand</i> <i>Coarse red gravel</i>	<i>0</i> <i>20</i> <i>130</i>	<i>20</i> <i>130</i> <i>143</i>
WELL LOCATION:			
sec. <i>28</i> T- <i>1</i> (N) R- <i>8</i> (E) <i>6</i> miles <i>E</i> of <i>Oxylo</i> (distance) (direction) (nearest town)			
WELL PURPOSE: <i>Home</i> (home, irrigation, municipal, industrial)			
WELL COMPLETION DATA:			
(1) diameter (inches) <i>4</i>			
(2) total depth (feet) <i>143</i>			
(3) static water level (feet) <i>80</i> below top of ground.			
(4) casing <i>Plastic</i> , <i>137</i> , (material) (depth) <i>4</i> if telescope see back. (size)			
(5) screen <i>6</i> , <i>137</i> (length) (depth to top)			
<i>4</i> , <i>Plastic</i> (size) (material)			
(6) pump <i>1</i> , <i>6</i> (HP) (yield gpm)			
<i>Electric</i> (type power)			
(7) electric log <i>Yes</i> (yes or no)			
(organization running log)			
(8) how well bottom plugged <i>Goodly</i>			
DRILLERS REMARKS:			


CODED

DEC 17 1970

MISS. BD. OF
WATER COM.

If well telescopes please sketch and show depths.

GROUND LEVEL

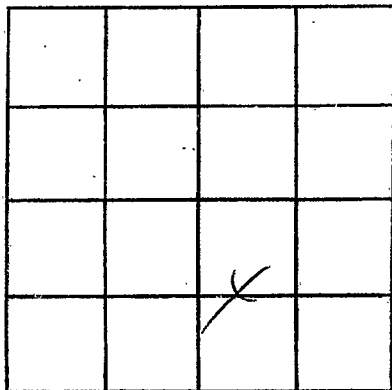

SECTION 28

Please indicate well location X.

ADDITIONAL INFORMATION

If more than one screen,
show locations of each on sketch.