

MISSISSIPPI  
BOARD OF WATER COMMISSIONERS  
416 North State Street  
Jackson, Mississippi 39201

**CODED**

WATER WELL DRILLERS LOG

Pike  
L 40  
2-4-70

Feb 4 1970 Reener well pump Co. Pike  
date well completed firm name county well located

LANDOWNER: James B. Wilson  
H. G. Magnolia  
(mailing address)

description of formations encountered	from	to
Red clay	0	16
Red sand	16	55
Sand & gravel	55	75
Chalky sand	75	80
Sand & gravel	80	93

WELL LOCATION:  
sec. 14 T. 1 N. R. 5 E.  
2 1/2 miles W. of Proctor.  
(distance) (direction) (nearest town)

WELL PURPOSE: farm  
(home, irrigation, municipal, industrial)

WELL COMPLETION DATA:

- (1) diameter (inches) 4"
- (2) total depth (feet) 93
- (3) static water level (feet) 78 below above top of ground.
- (4) casing Plastic bottom  
(material) (depth)
- (5) screen 6' 87'  
(length) (depth to top)  
4" Plastic  
(size) (material)
- (6) pump 1/2 sub 1 1/2  
(HP) (yield gpm)  
Rect  
(type power)
- (7) electric log no  
(yes or no)

**CODED**

(organization running log)

(8) how well bottom plugged wooden plug


DRILLERS REMARKS: New house.

FEB 27 1970

MISS. Bd. OF WATER COMMISSIONERS

If well telescopes please sketch and show depths.

GROUND LEVEL

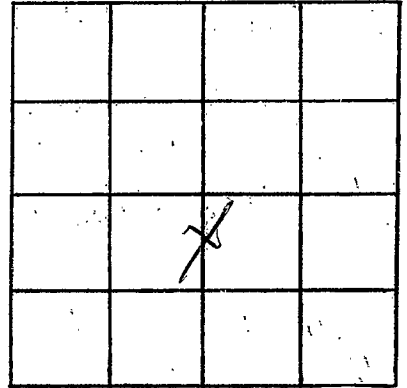

SECTION 14

Please indicate well location X.

ADDITIONAL INFORMATION

If more than one screen, show locations of each on sketch.