

Pike
L42
12-20-69

MISSISSIPPI
BOARD OF WATER COMMISSIONER
416 North State Street
Jackson, Mississippi 39201

CODED

WATER WELL DRILLERS LOG

20 Dec 1969 date well completed
J.T. Coimsta & Son Pipe firm name
Pike county well located

LANDOWNER: Louis V. Vardell
Oxyha (mailing address)
WELL LOCATION:
sec. 35 T 1 N R 8 E
6 miles East of Oxyha
(distance) (direction) (nearest town)

| description of formations encountered | from | to |
|---------------------------------------|------|-----|
| Clay | 0 | 20 |
| Clay/loam | 20 | 25 |
| Clay/loam | 25 | 35 |
| Sand/loam | 35 | 40 |
| Clay/loam | 40 | 160 |
| Gravel | 160 | 175 |

WELL PURPOSE:
(home, irrigation, municipal, industrial)

WELL COMPLETION DATA:
(1) diameter (inches) 4
(2) total depth (feet) 175
(3) static water level (feet) 90 below top of ground.
(4) casing 41 (material), 169 (depth)
(size) If telescope see back.
(5) screen 6 (length), 169 (depth to top)
4 (size), 41 (material)
(6) pump 5 (HP), 18 (yield gpm)
Elev (type power)
(7) electric log (yes or no)
(organization running log)
(8) how well bottom plugged wood

CODED


JAN 5 1970

MISS. DD. 01
WATER COMM.

DRILLERS REMARKS:

If well telescopes please sketch and show depths.

GROUND LEVEL

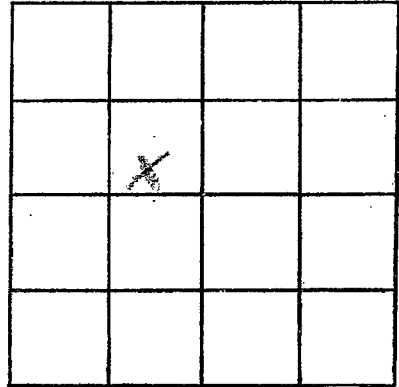

SECTION 30-

Please indicate well location X.

ADDITIONAL INFORMATION

Lined area for additional information with approximately 20 horizontal lines.

If more than one screen, show locations of each on sketch.