

CODED

MISSISSIPPI
BOARD OF WATER COMMISSIONERS
416 North State Street
Jackson, Mississippi 39201

FEB 19 1971

WATER WELL DRILLERS LOG

MISS. BD. OF
WATER COMM.

PIKE
L45
1-19-71

Drilled - 1-19-71

~~Completed~~ 19 71

Chester Keene

Pike

firm name

county well located

LANDOWNER: George Hood

description of formations encountered

from

to

RFD
Osborne's
(mailing address)

clay 0 15
sand 15 40
chalk 40 70
sand & clay gravel 70 82

WELL LOCATION:

sec. 10 T 1 N R 4 E
4 miles SE of Magnolia
(distance) (direction) (nearest town)

WELL PURPOSE: Home
(home, irrigation, municipal, industrial)

WELL COMPLETION DATA:

CODED

- (1) diameter (inches) 4"
- (2) total depth (feet) 82
- (3) static water level (feet) 35 below top of ground
- (4) casing ~~plastic~~ ~~galvanized~~
(material) (depth)
- (size) if telescope see back.
- (5) screen 6' 76'
(length) (depth to top)
1" ~~plastic~~
(size) (material)
- (6) pump (HP) (yield gpm)
(type power)
- (7) electric log ~~no~~
(yes or no)


(organization running log)

(8) how well bottom plugged
wooden plug

DRILLERS REMARKS:
new house

If well telescopes please sketch and show depths.

GROUND LEVEL

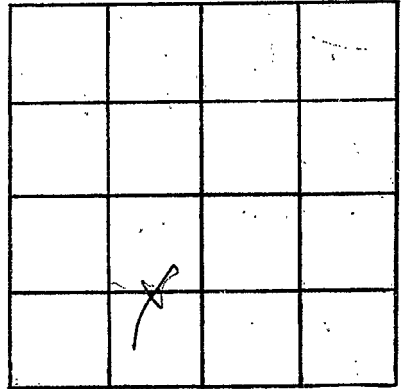

SECTION 10

Please indicate well location X.

ADDITIONAL INFORMATION

Lined area for additional information.

If more than one screen, show locations of each on sketch.