

PIKE

L 46

4-29-71

MISSISSIPPI BOARD OF WATER COMMISSIONERS
416 North State Street
Jackson, Mississippi 39201

CODED

WATER WELL DRILLERS LOG

April 29, 1971 Chester Reeves Pike
date well completed firm name county well located

LANDOWNER: Coral P. Fair
RFD - Osyka

(mailing address)

WELL LOCATION:
sec. 33 T. L N. R. 8 E
4 miles E of Osyka
(distance) (direction) (nearest town)

WELL PURPOSE: Home
(home, irrigation, municipal, industrial)

WELL COMPLETION DATA:

- (1) diameter (inches) 4"
- (2) total depth (feet) 153
- (3) static water level (feet) 70 below top of ground
- (4) casing Plast Bottom
(material) (depth)
- (size) if telescope see back.
- (5) screen 6' 127
(length) (depth to top)
- (size) Plast
(material)
- (6) pump Bayothers
(HP) (yield gpm)
- (type power)
- (7) electric log No
(yes or no)
- (organization running log)

| description of formations encountered | from | to |
|---|------------|------------|
| <u>Red clay</u> | <u>0</u> | <u>27</u> |
| <u>Red sand, shell & gravel</u> | <u>27</u> | <u>90</u> |
| <u>bank chucks & coarse sand & gravel</u> | <u>90</u> | <u>122</u> |
| | <u>122</u> | <u>133</u> |

CODED

(8) how well bottom plugged wooden plug


DRILLERS REMARKS: New location

APR 29 1971

MISS. BD. OF WATER COM.

If well telescopes please sketch and show depths.

GROUND LEVEL

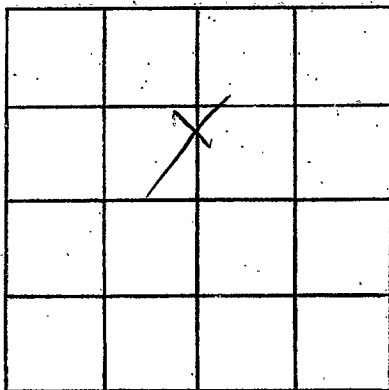

SECTION

33

Please indicate well location X.

ADDITIONAL INFORMATION

If more than one screen, show locations of each on sketch.