

PIKE
L 47
7-6-71

MISSISSIPPI
BOARD OF WATER COMMISSIONERS
416 North State Street
Jackson, Mississippi 39201

CODED

WATER WELL DRILLERS LOG

7-6 date well completed 1971 firm name *F. J. ...* county well located *Pike*

LANDOWNER:
C. W. Allen
R.R. Magnolia
(mailing address)

description of formations encountered	from	to
<i>Red clay</i>	<i>0</i>	<i>20</i>
<i>Red sand</i>	<i>20</i>	<i>60</i>
<i>Red gravel</i>	<i>65</i>	<i>80</i>
<i>Coarse sand</i>	<i>80</i>	<i>106</i>

WELL LOCATION:
sec. *2* T. *1* N. R. *8* E
S. W.
7 miles *E* of *Magnolia*
(distance) (direction) (nearest town)

WELL PURPOSE:
Home
(home, irrigation, municipal, industrial)

- WELL COMPLETION DATA:
- (1) diameter (inches) *4*
 - (2) total depth (feet) *105*
 - (3) static water level (feet) *60* below top of ground.
 - (4) casing *Plastic 99*
(material) (depth)
4 (size) if telescope see back.
 - (5) screen *6 99*
(length) (depth to top)
4 (size) *Plastic* (material)
 - (6) pump *1/2 5*
(HP) (yield gpm)
60 (type power)
 - (7) electric log *No*
(yes or no)
(organization running log)
 - (8) how well bottom plugged *Sealed*

CODED


III 22 1971

MISS. BD. OF
WATER COMMISSIONERS

DRILLERS REMARKS:

If well telescopes please sketch and show depths.

GROUND LEVEL

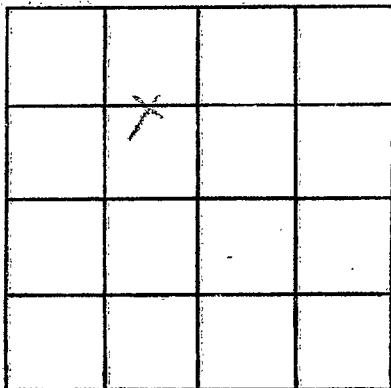

SECTION 2

Please indicate well location X.

ADDITIONAL INFORMATION

If more than one screen, show locations of each on sketch.