

Pike
L-48
7-22-71

MISSISSIPPI
BOARD OF WATER COMMISSIONERS
416 North State Street
Jackson, Mississippi 39201

WATER WELL DRILLERS LOG


CODED

7-22 1971 Fitzgerald Dr Pike
date well completed firm name county well located

LANDOWNER:	description of formations encountered	from	to
<u>Augustine Brock</u>	<u>Red clay</u>	<u>0</u>	<u>20</u>
<u>R.R. Magala Min.</u> (mailing address)	<u>Red sand</u>	<u>20</u>	<u>60</u>
WELL LOCATION:	<u>Red gravel</u>	<u>60</u>	<u>105</u>
sec. <u>12</u> T <u>1</u> N R <u>8</u> E <u>3</u> <u>12</u> (distance) miles (direction) of (nearest town)	<u>Red sand</u>	<u>105</u>	<u>115</u>
WELL PURPOSE: (home, irrigation, municipal, industrial)	<u>Coarse sand & gravel</u>	<u>115</u>	<u>134</u>
WELL COMPLETION DATA:	CODED		
(1) diameter (inches) <u>4</u>			
(2) total depth (feet) <u>124</u>			
(3) static water level (feet) <u>95</u> below above top of ground.			
(4) casing <u>plastic 118</u> (material) (depth)			
<u>4</u> (size) if telescope see back.			
(5) screen <u>6</u> <u>118</u> (length) (depth to top)			
<u>4</u> <u>plastic</u> (size) (material)			
(6) pump <u>1</u> <u>6</u> (HP) (yield gpm)			
<u>ole</u> (type power)			
(7) electric log <u>no</u> (yes or no)			
(organization running log)			
(8) how well bottom plugged <u>Woody</u>			
DRILLERS REMARKS:	AUG 11 1971 MISS. BD. OF SEWER & WATER COMM.		

If well telescopes please sketch and show depths.

GROUND LEVEL

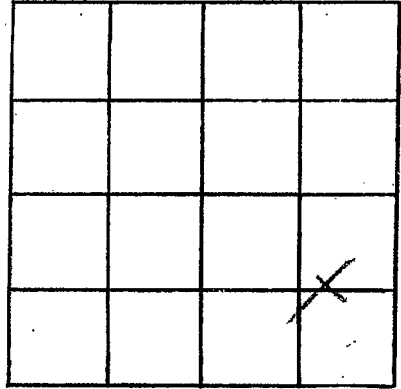

SECTION 12

Please indicate well location X.

ADDITIONAL INFORMATION

If more than one screen,
show locations of each on sketch.