

MISSISSIPPI
 BOARD OF WATER COMMISSIONERS
 416 North State Street
 Jackson, Mississippi 39201

CODED

WATER WELL DRILLERS LOG

Pike
 L-49
 7-17-71

7-17 19 71
 date well completed

Fitzgerald
 firm name

Pike
 county well located

LANDOWNER:	description of formations encountered	from	to
Bill Bantz	Red clay	0	20
R.R. Beyhannin (mailing address)	White clay Coarse sand	20	80 100
WELL LOCATION:			
sec. 36 T 1 N R 8 E 7 miles W of Osyka (distance) (direction) (nearest town)			
WELL PURPOSE: (home, irrigation, municipal, industrial)			
WELL COMPLETION DATA:			
(1) diameter (inches) 4			
(2) total depth (feet) 100			
(3) static water level (feet) 40 below top of ground.			
(4) casing plastic 94 (material), (depth) 4 (size) if telescope see back.			
(5) screen 6 (length), 94 (depth to top)			
(6) pump 4 (size), plastic (material)			
(7) pump 1 (HP), 6 (yield gpm)			
(type power) Elec			
(7) electric log (yes or no) No			
(organization running log)			
(8) how well bottom plugged well			
DRILLERS REMARKS:			


CODED

AUG 11 1971

MISS. BD. OF
 WATER COMM.

If well telescopes please sketch and show depths.

GROUND LEVEL

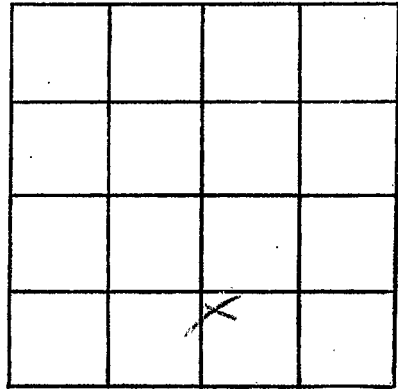

SECTION 36

Please indicate well location X.

ADDITIONAL INFORMATION

If more than one screen,
show locations of each on sketch.