

Pike
L-50
8-20-71

MISSISSIPPI
BOARD OF WATER COMMISSIONERS
416 North State Street
Jackson, Mississippi 39201

CODED

WATER WELL DRILLERS LOG

ALDIE PUMP & WELL SUPPLY CO., INC.

8-20 1971
date well completed

firm name

Pike
county well located

LANDOWNER:

Willie Mae Varnado

description of formations encountered

from

to

R 1 Box 617 Osyka
(mailing address)

clay	0	70
fine sand	70	130
coarse sand & gravel	130	144

WELL LOCATION:

sec. 36 T 1 N R 8 E
S W
8 miles E. of Osyka
(distance) (direction) (nearest town)

WELL PURPOSE:

Home
(home, irrigation, municipal, industrial)

WELL COMPLETION DATA:

- (1) diameter (inches) 4
- (2) total depth (feet) 144'
- (3) static water level (feet) 75' below top of ground.
- (4) casing PVC 139'
(material) (depth)
2" (size) if telescope see back.
- (5) screen 5' 139'
(length) (depth to top)
2" PVC
(size) (material)
- (6) pump 1 HP 8 GPM
(HP) (yield gpm)
Elect.
(type power)
- (7) electric log NO
(yes or no)

(organization running log)

- (8) how well bottom plugged

plastic cap

DRILLERS REMARKS:


SEP 1 1971

MISS. BD. OF
WATER COMM.

If well telescopes please sketch and show depths.



GROUND LEVEL

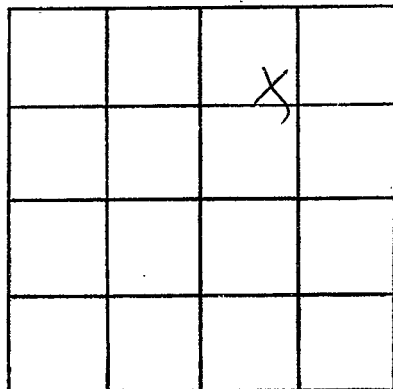

SECTION 36

Please indicate well location X.

ADDITIONAL INFORMATION

If more than one screen,
show locations of each on sketch.