

Pike  
L52  
10-4-71

MISSISSIPPI  
BOARD OF WATER COMMISSIONERS  
416 North State Street  
Jackson, Mississippi 39201

WATER WELL DRILLERS LOG

10-4 date well completed 1971 Filgabwell firm name Pike county well located

LANDOWNER:	description of formations encountered	from	to
Betsy Williams			
P.R. Magnolia Miss. (mailing address)	Red dirt	26	80
	Coarse sand & gravel	80	95

**CODED**

WELL LOCATION:  
sec. 24 T 1 N R 8 E  
1 miles W of Bogalusa  
(distance) (direction) (nearest town)

WELL PURPOSE: Home  
(home, irrigation, municipal, industrial)

- WELL COMPLETION DATA:
- (1) diameter (inches) 4
  - (2) total depth (feet) 95
  - (3) static water level (feet) 50 below top of ground.
  - (4) casing Plaster, 89 (material), (depth)  
6 (size) if telescope see back.
  - (5) screen 6 (length), 89 (depth to top)  
4 (size), Plaster (material)
  - (6) pump 1 (HP), 5 (yield gpm)  
ell (type power)
  - (7) electric log no (yes or no)  
(organization running log)
  - (8) how well bottom plugged Good plug

**CODED**


OCT 28 1971

MISS. BD. OF  
WATER COM.

DRILLERS REMARKS:

If well telescopes please sketch and show depths.

GROUND LEVEL

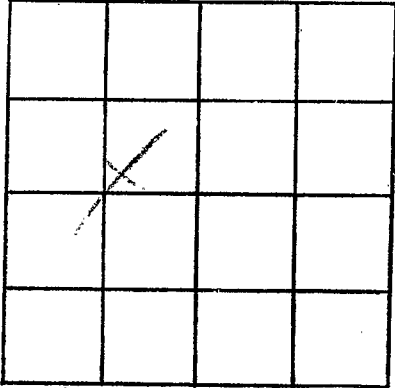

SECTION 24

Please indicate well location X.

ADDITIONAL INFORMATION

If more than one screen, show locations of each on sketch.