

Pike
L 54
10-5-71

MISSISSIPPI
BOARD OF WATER COMMISSIONERS
416 North State Street
Jackson, Mississippi 39201

DEC 28 1971

MISS. BD. OF
WATER COMM

WATER WELL DRILLERS LOG

date well completed oct 4 1971 firm name Chester Keen **CODED** county well located Pike

LANDOWNER: Albert Sumner
RFD 1, Osyka
(mailing address)

description of formations encountered	from	to
clay	0	10
sand	10	90
gravel	90	100
Sand & gravel	100	115

WELL LOCATION:
sec. 14 T 1 N R. 9 E
3 miles N of Prepers
(distance) (direction), (nearest town)

WELL PURPOSE: Home
(home, irrigation, municipal, industrial)

- WELL COMPLETION DATA:
- (1) diameter (inches) 4"
 - (2) total depth (feet) 115
 - (3) static water level (feet) 52 below top of ground.
 - (4) casing Plast. Bottom
(material) (depth)
 - (size) if telescope see back.
 - (5) screen 6' 109
(length) (depth to top)
 - 1/2" Plast
(size) (material)
 - (6) pump 1/2 HP 15
(HP) (yield gpm)
 - elect
(type power)
 - (7) electric log No.
(yes or no)
 - (organization running log)


CODED

(8) how well bottom plugged wooden plug

DRILLERS REMARKS:
all tip well
not adequate

If well telescopes please sketch and show depths.

GROUND LEVEL

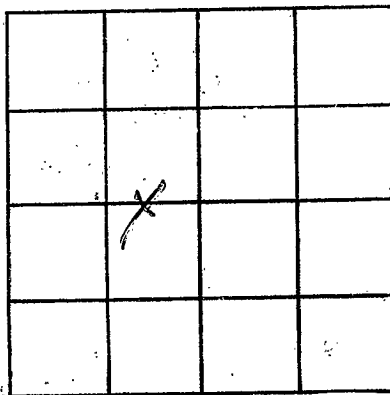

SECTION *14*

Please indicate well location X.

ADDITIONAL INFORMATION

If more than one screen, show locations of each on sketch.