

MISSISSIPPI
 BOARD OF WATER COMMISSIONERS
 416 North State Street
 Jackson, Mississippi 39201

COPIED

WATER WELL DRILLERS LOG

Pike
 L55
 1-27-72

Jan 27 1972 date well completed
 Chester Keenes firm name
 Pike county well located

LANDOWNER: Beltcher
Cap. Church
RFD, Magnolia
 (mailing address)

description of formations encountered	depth	
	from	to
clay	0	10
sand	10	50
chalk sand	50	75
chalk	75	80
sand & gravel	80	96

WELL LOCATION:
 sec. 17 T. 1 N. R. 8 E.
4 miles NE Oxyba
 (distance) (direction) (nearest town)

WELL PURPOSE: church
 (home, irrigation, municipal, industrial)

WELL COMPLETION DATA:
 (1) diameter (inches) 4"
 (2) total depth (feet) 96
 (3) static water level (feet) 72 below top of ground.
 (4) casing Plastic (material) 80' (depth)
 (size) if telescope see back.
 (5) screen 6' (length) 90' (depth to top)
4" (size) plastic (material)
 (6) pump 1/2 HP (HP) 6 (yield gpm)
Elect. (type power)
 (7) electric log no (yes or no)
 (organization running log)
 (8) how well bottom plugged wooden plug

COPIED


JAN 31 1972

DRILLERS REMARKS:

MISS. RD. OF
 WATER COMM

If well telescopes please sketch and show depths.

GROUND LEVEL

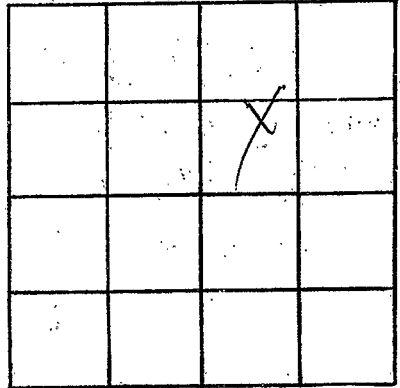

SECTION 17

Please indicate well location X.

ADDITIONAL INFORMATION

If more than one screen, show locations of each on sketch.