

Pike
L 56
1-19-72

MISSISSIPPI
BOARD OF WATER COMMISSIONERS
416 North State Street
Jackson, Mississippi 39201

CODED

WATER WELL DRILLERS LOG

Jan 19 19 72 *Fitzgerald Well Dr* *Pike*
date well completed firm name county well located

LANDOWNER:
Creston Vancadore
R.R. Ozyka
(mailing address)

description of formations encountered	from	to
<i>Red clay</i>	<i>0</i>	<i>20</i>
<i>Red sand</i>	<i>20</i>	<i>25</i>
<i>Coarse sand & gravel</i>	<i>25</i>	<i>84</i>

WELL LOCATION:
sec. *35* T *1* N R *8* E
6 miles *E* of *Ozyka*
(distance) (direction) (nearest town)

WELL PURPOSE: *Home*
(home, irrigation, municipal, industrial)

- WELL COMPLETION DATA:
- (1) diameter (inches) *4*
 - (2) total depth (feet) *84*
 - (3) static water level (feet) *50* below above top of ground.
 - (4) casing *plastic, 76*
(material) (depth)
4 if telescope see back.
(size)
 - (5) screen *8, 76*
(length) (depth to top)
4, *plastic*
(size) (material)
 - (6) pump *1, 8*
(HP) (yield gpm)
elec
(type power)
 - (7) electric log *no*
(yes or no)
(organization running log)
 - (8) how well bottom plugged *used peg*


CODED

DRILLERS REMARKS:

FEB 28 1972

If well telescopes please sketch and show depths.

GROUND LEVEL

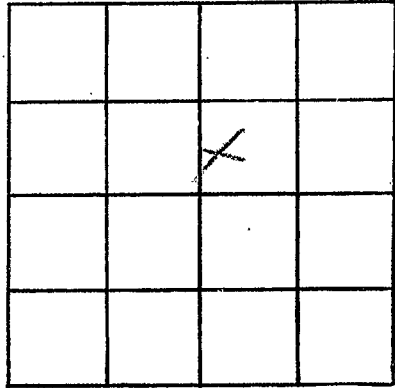

SECTION 35

Please indicate well location X.

ADDITIONAL INFORMATION

If more than one screen,
show locations of each on sketch.