

Pike
L 57
3-16-72

CODED MISSISSIPPI
BOARD OF WATER COMMISSIONERS
416 North State Street
Jackson, Mississippi 39201

MAR 21 1972

WATER WELL DRILLERS LOG


3-16 1972 *St. James well* *Pike*
date well completed firm name county well located

LANDOWNER:	description of formations encountered	from	to
<i>James Neal</i> <i>RR Magnolia Miss.</i> (mailing address)	<i>Red clay</i> <i>Red sand</i> <i>Red gravel</i> <i>Coarse sand & gravel</i>	<i>0</i> <i>22</i> <i>92</i> <i>110</i>	<i>25</i> <i>90</i> <i>110</i> <i>118</i>
WELL LOCATION: sec <i>9</i> T <i>1</i> N R <i>8</i> E <i>8</i> miles <i>SE</i> of <i>Magnolia</i> (distance) (direction) (nearest town)			
WELL PURPOSE: (home, irrigation, municipal, industrial)			
WELL COMPLETION DATA:			
(1) diameter (inches) <i>4</i>			
(2) total depth (feet) <i>118</i>			
(3) static water level (feet) <i>85</i> below top of ground.			
(4) casing <i>plastic</i> <i>110</i> (material) (depth)			
<i>4</i> if telescope see back. (size)			
(5) screen <i>8</i> <i>110</i> (length) (depth to top)			
<i>4</i> <i>plastic</i> (size) (material)			
(6) pump <i>1</i> <i>6</i> (HP) (yield gpm)			
<i>elec</i> (type power)			
(7) electric log <i>✓</i> (yes or no)			
(organization running log)			
(8) how well bottom plugged <i>cleanly</i>			
DRILLERS REMARKS:			

CODED

If well telescopes please sketch and show depths.

GROUND LEVEL

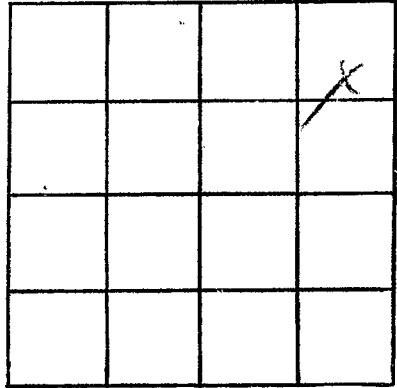

SECTION 9

Please indicate well location X.

ADDITIONAL INFORMATION

If more than one screen,
show locations of each on sketch.