

Pike  
L 59  
5-26-72

MISSISSIPPI  
BOARD OF WATER COMMISSIONERS  
416 North State Street  
Jackson, Mississippi 39201

**CODED**

WATER WELL DRILLERS LOG

May 20 1972 Chester Keener Pike  
date well completed firm name county well located

LANDOWNER: Florida  
Nobles  
H. Ayha  
(mailing address)

WELL LOCATION:  
sec. 36 T. L N. R. 8 E  
7 miles E of Ayha  
(distance) (direction) (nearest town)

WELL PURPOSE: Home  
(home, irrigation, municipal, industrial)

- WELL COMPLETION DATA:
- (1) diameter (inches) 4"
  - (2) total depth (feet) 118
  - (3) static water level (feet) 178 below top of ground.
  - (4) casing Plast Ballon  
(material) (depth)
  - (size) if telescope see back.
  - (5) screen 6' 112  
(length) (depth to top)
  - 4" Plast  
(size) (material)
  - (6) pump 1/2 12  
(HP) (yield gpm)
  - 2HP  
(type power)
  - (7) electric log No  
(yes or no)

(organization running log)

(8) how well bottom dug wooden plug

DRILLERS REMARKS:  
New location

description of formations encountered	from	to
<u>red clay</u>	<u>0</u>	<u>18</u>
<u>red sand</u>	<u>18</u>	<u>63</u>
<u>sand gravel</u>	<u>63</u>	<u>90</u>
<u>pink chalk</u>	<u>90</u>	<u>104</u>
<u>sand</u>	<u>104</u>	<u>118</u>


**CODED**

JUN 30 1972

MISSISSIPPI COMMISSIONERS

If well telescopes please sketch and show depths.

GROUND LEVEL

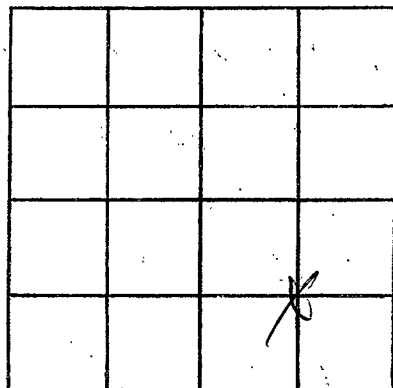

SECTION 30

Please indicate well location X.

ADDITIONAL INFORMATION

If more than one screen,  
show locations of each on sketch.