

Pike  
L 61  
9-13-72

MISSISSIPPI  
BOARD OF WATER COMMISSIONERS  
416 North State Street  
Jackson, Mississippi 39201

WATER WELL DRILLERS LOG

9-13 1972 *Fitzgerald* *Pike*  
date well completed firm name county well located

LANDOWNER:

*Emma Carter*

*R.R. Magnolia Miss*  
(mailing address)

WELL LOCATION:

sec. 2 T. 10 S. R. 3 E.  
9 miles SE of MAGNOLIA  
(distance) (direction) (nearest town)

WELL PURPOSE: Home  
(home, irrigation, municipal, industrial)

WELL COMPLETION DATA:

- (1) diameter (inches) 4
- (2) total depth (feet) 128
- (3) static water level (feet) 45 below above top of ground.
- (4) casing Plastic 120  
(material) (depth)  
4 if telescope see back.  
(size)
- (5) screen 8 120  
(length) (depth to top)  
4 Plastic  
(size) (material)
- (6) pump 1/2 6  
(HP) (yield gpm)  
Electric  
(type power)
- (7) electric log No  
(yes or no)  
(organization running log)
- (8) how well bottom plugged about 50%

description of formations encountered

from to

*Red Clay* 0 20  
*Red Sand* 20 60  
*white clay* 60 115  
*limestone* 115 128

CODED

CODED


OCT 17 1972

DRILLERS REMARKS:

MISS. BOARD OF WATER COMMISSIONERS

If well telescopes please sketch and show depths.

GROUND LEVEL

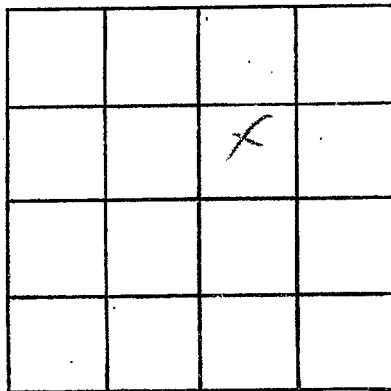

SECTION 2

Please indicate well location X.

ADDITIONAL INFORMATION

If more than one screen, show locations of each on sketch.