

Pike
L 62
10-7-72

MISSISSIPPI
BOARD OF WATER COMMISSIONERS
416 North State Street
Jackson, Mississippi 39201

WATER WELL DRILLERS LOG

CODED

Oct 7 1972 Chester Karnes Pike
date well completed firm name county well located

LANDOWNER: Kenneth
Baskin
411 Osyka
(mailing address)

description of formations encountered	from	to
clay	0	17
sand & gravel	17	28
sand & chalk mixed	28	52
pea gravel & coarse sand	52	67

WELL LOCATION:
sec. 30 T. 1 N. R. 4 E
1 1/2 miles NE of Osyka
(distance) (direction) (nearest town)

WELL PURPOSE: Domestic
(home, irrigation, municipal, industrial)

WELL COMPLETION DATA:

- (1) diameter (inches) 4"
- (2) total depth (feet) 67
- (3) static water level (feet) 26 below top of ground.
- (4) casing Plast. Ballou
(material) (depth)
- _____ if telescope see back.
(size)
- (5) screen 6', 6'
(length) (depth to top)
- 1/2", Plast
(size) (material)
- (6) pump Byoung
(HP) (yield gpm)
- _____ (type power)
- (7) electric log NO
(yes or no)
- _____ (organization running log)

CODED


(8) how well bottom plugged wood plug
DRILLERS REMARKS: old well had

DEC 4 1972

MIS. Bd. of
WATER COMM.

If well telescopes please
sketch and show depths.

GROUND LEVEL

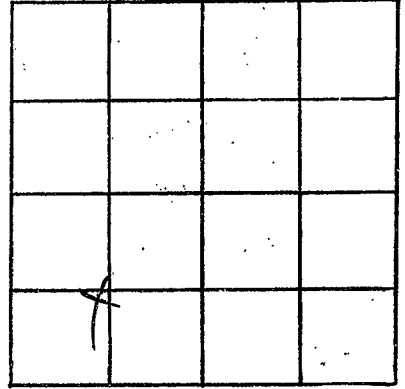

SECTION 30

Please indicate well location X.

ADDITIONAL INFORMATION

If more than one screen,
show locations of each on sketch.