

Pike
L 63
12-11-72

MISSISSIPPI
BOARD OF WATER COMMISSIONERS
416 North State Street
Jackson, Mississippi 39201

CODED

WATER WELL DRILLERS LOG

11 Dec 1972 *J.T. Construction* Pike
date well completed firm name county well located

LANDOWNER: Alex James
Magnolia (mailing address)
description of formations encountered: Clay, Chalk Bed, Sand
from to: 0 70, 70 92, 92 92

WELL LOCATION:
sec. 14 T. 1 N. R. 9 E
1.0 miles SE of Magnolia
(distance) (direction) (nearest town)

WELL PURPOSE:
(home, irrigation, municipal, industrial)

- WELL COMPLETION DATA:
- (1) diameter (inches) 4
 - (2) total depth (feet) 92
 - (3) static water level (feet) 70 below top of ground
 - (4) casing (material) PI (depth) 86
 - (5) screen (length) 6 (depth to top) 86
 - (6) pump (HP) 4 (yield gpm) 8
 - (7) electric log (yes or no) elect
 - (8) how well bottom plugged wood


CODED

DRILLERS REMARKS:

FEB 12 1973

If well telescopes please sketch and show depths.

GROUND LEVEL

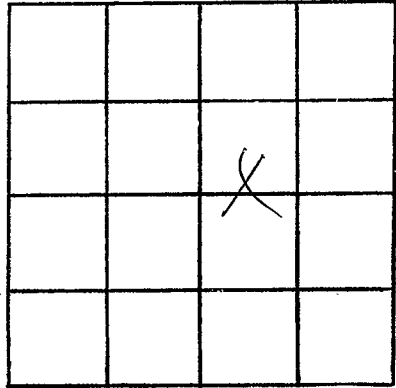

SECTION 14

Please indicate well location X.

ADDITIONAL INFORMATION

If more than one screen,
show locations of each on sketch.