

PIKE
L 65
7-23-73

MISSISSIPPI
BOARD OF WATER COMMISSIONERS
416 North State Street
Jackson, Mississippi 39201

CODEL

WATER WELL DRILLERS LOG

April 23 1973 J. T. Covington & Son PIKE
date well completed firm name county well located

LANDOWNER:

Woodrow Smith

Map

(mailing address)

description of formations encountered

from

to

Clay 0 20
Chalk 20 60
Sand 60 89

WELL LOCATION:

sec. 11 T. 1 N R. 8 E
8 miles SE of Map
(distance) (direction) (nearest town)

WELL PURPOSE:

(home, irrigation, municipal, industrial)

WELL COMPLETION DATA:

- (1) diameter (inches) 4
- (2) total depth (feet) 89
- (3) static water level (feet) 70 below top of ground.
- (4) casing (material) PL (depth) 83
- (size) If telescope see back.
- (5) screen (length) 6 (depth to top) 83
- (size) 4 (material) PL
- (6) pump (HP) 1/2 (yield gpm) 8
- (type power) split
- (7) electric log (yes or no)

(organization running log)


- (8) how well bottom plugged wood

DRILLERS REMARKS:

APR 17 1973

If well telescopes please sketch and show depths.

GROUND LEVEL

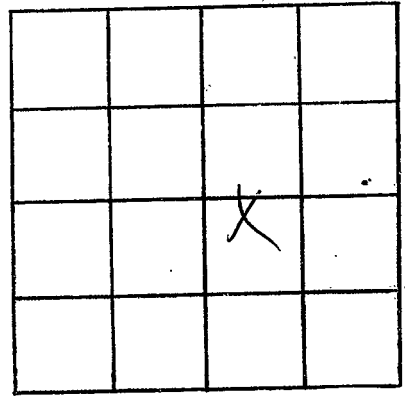

SECTION 11

Please indicate well location X.

ADDITIONAL INFORMATION

A series of horizontal lines for writing additional information.

If more than one screen, show locations of each on sketch.