

CODED

MISSISSIPPI
BOARD OF WATER COMMISSIONERS
416 North State Street
Jackson, Mississippi 39201

WATER WELL DRILLERS LOG

L 66
PIKE
7-19-73

7-19
date well completed


1973 *Fitzgerald Well Dr.*
firm name

Peru
county well located

LANDOWNER:	description of formations encountered	depth	
		from	to
<i>Janis Duth</i> <i>R.R. Oryha miss.</i> (mailing address)	<i>Red clay</i> <i>Red sand</i> <i>Red gravel</i> <i>Coarse sand</i>	0 20 80 100	20 80 160 114
WELL LOCATION: sec. <i>2</i> T <i>1</i> N R <i>8</i> E S W <i>5</i> miles <i>N</i> of <i>Oryha</i> (distance) (direction) (nearest town)			
WELL PURPOSE: (home, irrigation, municipal, industrial)			
WELL COMPLETION DATA:			
(1) diameter (inches) <i>4</i>			
(2) total depth (feet) <i>114</i>			
(3) static water level (feet) <i>80</i> below above top of ground.			
(4) casing <i>plastic, 106</i> , (material) (depth) <i>4</i> if telescope see back. (size)			
(5) screen <i>8</i> , <i>106</i> (length) (depth to top) <i>4</i> , <i>plastic</i> (size) (material)			
(6) pump <i>1/2</i> , <i>10</i> (HP) (yield gpm) <i>ele</i> (type power)			
(7) electric log <i>no</i> (yes or no) (organization running log)			
(8) how well bottom plugged <i>wood pl</i>			
DRILLERS REMARKS:			

If well telescopes please sketch and show depths.

GROUND LEVEL

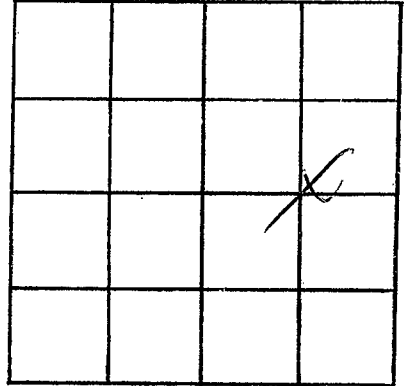

SECTION 7

Please indicate well location X.

ADDITIONAL INFORMATION

If more than one screen, show locations of each on sketch.