

L 67  
PIKE  
4-24-73

MISSISSIPPI  
BOARD OF WATER COMMISSIONERS  
416 North State Street  
Jackson, Mississippi 39201

**CODED**

WATERWELL DRILLERS LOG

April 24 1973 *Chester Keene* *Pike*  
date well completed firm name county well located

LANDOWNER: *Mrs. Clifton*

*Sandwich*  
*H. Osyka*  
(mailing address)

description of formations encountered

from to

<i>Red Clay</i>	<i>0</i>	<i>28</i>
<i>Red Sand</i>	<i>18</i>	<i>80</i>
<i>Sand &amp; gravel</i>	<i>40</i>	<i>86</i>
<i>Red chalk</i>	<i>80</i>	<i>111</i>
<i>Sand</i>	<i>111</i>	<i>141</i>

WELL LOCATION:

sec. *27* T *1* N R *8* E  
*5* miles *ENE* of *Osyka*  
(distance) (direction) (nearest town)

WELL PURPOSE: *Home*  
(home, irrigation, municipal, industrial)

WELL COMPLETION DATA:

- (1) diameter (inches) *16"*
- (2) total depth (feet) *141'*
- (3) static water level (feet) *63* below top of ground
- (4) casing *Plast. battans*  
(material) (depth)
- \_\_\_\_\_ if telescope see back.  
(size)
- (5) screen *6'* *135'*  
(length) (depth to top)
- 4"* *Plast*  
(size) (material)
- (6) pump *Kyamer*  
(HP) (yield gpm)
- \_\_\_\_\_ (type power)
- (7) electric log *No*  
(yes or no)
- \_\_\_\_\_ (organization running log)

**CODED**


(8) how well bottom plugged  
*wooden plug*

DRILLERS REMARKS:  
*old well bad*

AUG 20 1973

If well telescopes please sketch and show depths.

GROUND LEVEL

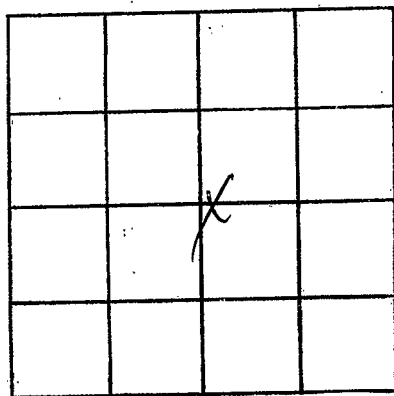

SECTION 27

Please indicate well location X.

ADDITIONAL INFORMATION

If more than one screen, show locations of each on sketch.