

L 68
 PIKE
 5-1-73

MISSISSIPPI
 BOARD OF WATER COMMISSIONERS
 416 North State Street
 Jackson, Mississippi 39201

CODED

WATER WELL DRILLERS LOG

May 1 1973 date well completed
 Chester Keene firm name
 Pike county well located

LANDOWNER: Tom Fisher
 H. Osypa

description of formations encountered	from	to
Red Clay	0	10
Mixed Red Shale & Sand	16	64
Small gravel & sand	64	76
Tabular sand	76	100
Gravel & Sand	100	114

(mailing address)

WELL LOCATION:
 sec. 27 T. 1 N. R. 5 E
 3/4 miles SW of Poplar (distance) (direction) (nearest town)

WELL PURPOSE: Farm (home, irrigation, municipal, industrial)

WELL COMPLETION DATA:

- (1) diameter (inches) 4'
- (2) total depth (feet) 114
- (3) static water level (feet) 70 below top of ground above
- (4) casing (material) (depth) Plast. Bottom
- (5) screen (size) (length) (depth to top) 6' 108'
- (6) pump (size) (material) (HP) (yield gpm) 1/2
- (7) electric log (yes or no) NO
- (organization running log)

CODED


(8) how well bottom plugged wooden plug

DRILLERS REMARKS: New house

AUG 20 1973

If well telescopes please sketch and show depths.

GROUND LEVEL

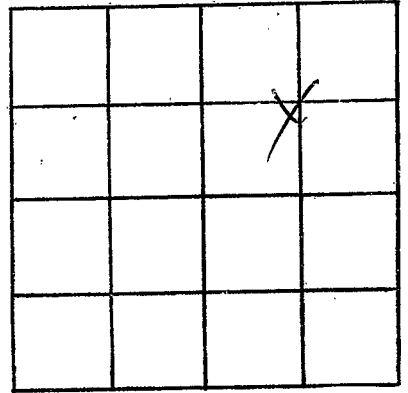

SECTION 29

Please indicate well location X.

ADDITIONAL INFORMATION

If more than one screen,
show locations of each on sketch.