

PRICE  
L 70  
8-28-73

MISSISSIPPI BOARD OF WATER COMMISSIONERS  
416 North State Street  
Jackson, Mississippi 39201

CODED

WATER WELL DRILLERS LOG

8-28 19 73 *General well* Peche  
date well completed firm name county well located

LANDOWNER:  
William H. Long

R.R. Ogden Min  
(mailing address)

WELL LOCATION:  
sec. 33 T. 10 N. R. 8 E  
8 miles E of Ogden  
(distance) (direction) (nearest town)

WELL PURPOSE: Home  
(home, irrigation, municipal, industrial)

WELL COMPLETION DATA:

- (1) diameter (inches) 4
- (2) total depth (feet) 120
- (3) static water level (feet) 70 below top of ground.
- (4) casing PLASTIC 1 1/2  
(material) (depth)  
4 if telescope see back.  
(size)
- (5) screen 8 112  
(length) (depth to top)  
4 plastic  
(size) (material)
- (6) pump 1/2 10  
(HP) (yield gpm)  
elec  
(type power)
- (7) electric log (yes or no) X  
(organization running log)
- (8) how well bottom plugged Wood plug

description of formations encountered	depth	
	from	to
<u>Red clay</u>	<u>0</u>	<u>20</u>
<u>Red gravel</u>	<u>20</u>	<u>110</u>
<u>Cocum sand &amp; gravel</u>	<u>110</u>	<u>120</u>


CODED

DRILLERS REMARKS:

OCT 9 1973

If well telescopes please sketch and show depths.

GROUND LEVEL

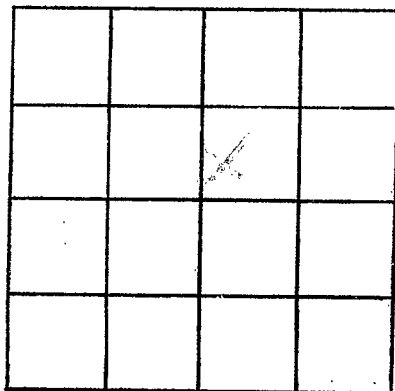

SECTION 33

Please indicate well location X.

ADDITIONAL INFORMATION

If more than one screen,  
show locations of each on sketch.