

PIKE
L 73
10-19-73

MISSISSIPPI
BOARD OF WATER COMMISSIONERS
416 North State Street
Jackson, Mississippi 39201

CODED

WATER WELL DRILLERS LOG

10-19 date well completed 19 73 firm name *Fitzgerald* county well located *Pike*

LANDOWNER:

Mike Holmes

description of formations encountered

from to

R.R. Oyster
(mailing address)

Red clay 0 20
Red sand 20 110
Coarse sand & gravel 110 120

WELL LOCATION:

sec 9 T 1 N R 20 E
5 miles NNE of Oyster
(distance) (direction) (nearest town)

WELL PURPOSE:
(home, irrigation, municipal, industrial)

WELL COMPLETION DATA:

- (1) diameter (inches) 4
- (2) total depth (feet) 120
- (3) static water level (feet) 50 below above top of ground.
- (4) casing plastic, 112,
(material) (depth)
4 if telescope see back.
(size)
- (5) screen 8, 112
(length) (depth to top)
4, plastic
(size) (material)
- (6) pump 1/2 10
(HP) (yield gpm)
90
(type power)
- (7) electric log no
(yes or no)
(organization running log)
- (8) how well bottom plugged unplugged


CODED

DRILLERS REMARKS:

NOV 15 1973

If well telescopes please sketch and show depths.

GROUND LEVEL

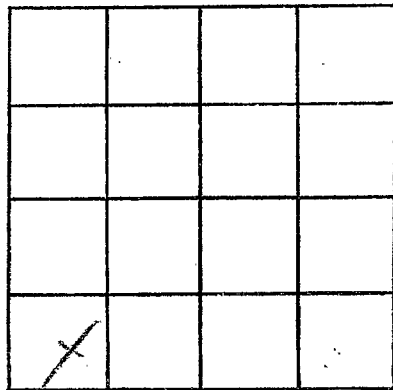

SECTION 9

Please indicate well location X.

ADDITIONAL INFORMATION

If more than one screen,
show locations of each on sketch.