

PIKE  
L 74  
2-11-74

MISSISSIPPI  
BOARD OF WATER COMMISSIONERS  
416 North State Street  
Jackson, Mississippi 39201

CODED

WATER WELL DRILLERS LOG

2-11 date well completed: 1974 firm name: Flynn's Well Service county well located: Pike

LANDOWNER:

Myrtle Pass -

R.R. Myrtle  
(mailing address)

description of formations encountered:

from to

<u>Red Clay</u>	<u>0</u>	<u>20</u>
<u>Red Sand</u>	<u>20</u>	<u>125</u>
<u>Coarse Sand &amp; Gravel</u>	<u>125</u>	<u>140</u>

WELL LOCATION:

sec. 12 T. 1 N. R. 8 E.  
9 miles SE of Myrtle  
(distance) (direction) (nearest town)

WELL PURPOSE: Home  
(home, irrigation, municipal, industrial)

WELL COMPLETION DATA:

- (1) diameter (inches) 4
- (2) total depth (feet) 140
- (3) static water level (feet) 70 below above top of ground.
- (4) casing Plastic, 132  
(material) (depth)  
4 If telescope see back.  
(size)
- (5) screen 8, 132  
(length) (depth to top)  
4, Plastic  
(size) (material)
- (6) pump 1/2 10  
(HP) (yield gpm)  
elec  
(type power)
- (7) electric log no  
(yes or no)  
(organization running log)
- (8) how well bottom plugged Sand Stop

CODED


DRILLERS REMARKS:

FEB 25 1974

MISSISSIPPI BOARD OF WATER COMMISSIONERS

If well telescopes please sketch and show depths.

GROUND LEVEL

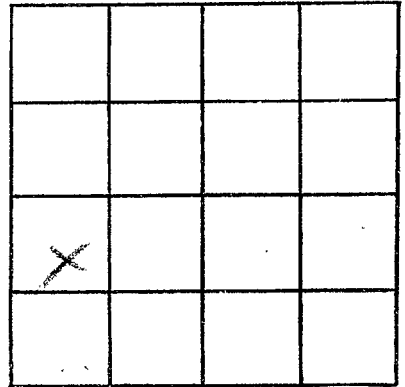

SECTION 12

Please indicate well location X.

ADDITIONAL INFORMATION

If more than one screen, show locations of each on sketch.