

PIKE  
LTS  
3-4-74

MISSISSIPPI  
BOARD OF WATER COMMISSIONERS  
416 North State Street  
Jackson, Mississippi 39201

CODED

WATER WELL DRILLERS LOG

3-4 19 74 Fitzgerald Lea Pike  
date well completed firm name county well located

LANDOWNER:

Randy Rhodes

description of formations encountered

from to

RR - Magnolia  
(mailing address)

Red Clay 0 20  
Red Sand 20 110  
Coarse Sand & Gravel 110 126

WELL LOCATION:

sec. 6 T 10 N R 3 E  
4 miles S of Magnolia  
(distance) (direction) (nearest town)

WELL PURPOSE: Home  
(home, irrigation, municipal, industrial)

WELL COMPLETION DATA:

- (1) diameter (inches) 4
- (2) total depth (feet) 126
- (3) static water level (feet) 80 below above top of ground.
- (4) casing Plastic, 118,  
(material) (depth)  
4 if telescope see back.  
(size)
- (5) screen 8 118  
(length) (depth to top)  
4, Plastic  
(size) (material)
- (6) pump 1/2 10  
(HP) (yield gpm)  
Electric  
(type power)
- (7) electric log no  
(yes or no)
- (8) how well bottom plugged Seal block

CODED


MAY 10 1974

MISS. BD. OF WATER COMMISSIONERS

DRILLERS REMARKS:

If well telescopes please sketch and show depths.

GROUND LEVEL

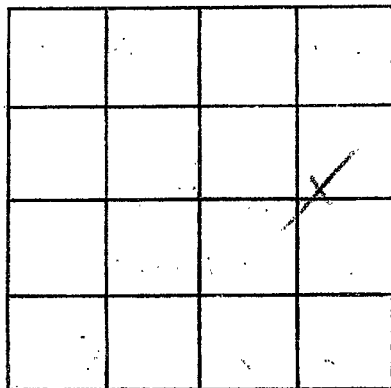

SECTION 6

Please indicate well location X.

ADDITIONAL INFORMATION

If more than one screen, show locations of each on sketch.