

PIKE
L 76
4-5-74

MISSISSIPPI
BOARD OF WATER COMMISSIONERS
416 North State Street
Jackson, Mississippi 39201

CODED

WATER WELL DRILLERS LOG

4-5
date well completed

19 *H. Fitzgerald*
firm name

Pike
county well located

LANDOWNER:

Margie Landifer

R.R. Osyka
(mailing address)

description of formations encountered

from to

<i>Red clay</i>	<i>2</i>	<i>20</i>
<i>Red gravel</i>	<i>20</i>	<i>50</i>
<i>Red Soil</i>	<i>50</i>	<i>85</i>
<i>Coarse sand & gravel</i>	<i>85</i>	<i>96</i>

WELL LOCATION:

sec *26* T *1* N R *8* E
8 miles *E* of *Osyka*
(distance) (direction) (nearest town)

WELL PURPOSE: *Home*
(home, irrigation, municipal, industrial)

WELL COMPLETION DATA:

- (1) diameter (inches) 4
- (2) total depth (feet) 96
- (3) static water level (feet) 50 below above top of ground.
- (4) casing *plastic*, *88*,
(material) (depth)
4 if telescope see back.
(size)
- (5) screen *8*, *88*
(length) (depth to top)
4, *plastic*
(size) (material)
- (6) pump *1/2* *10*
(HP) (yield gpm)
like
(type power)
- (7) electric log *no*
(yes or/no)
(organization running log)
- (8) how well bottom plugged *filled*


CODED

DRILLERS REMARKS:

APR 10 1974

If well telescopes please sketch and show depths.

GROUND LEVEL

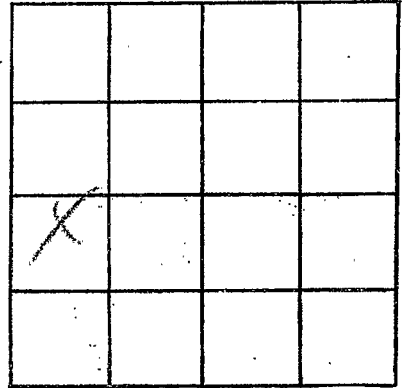

SECTION 26

Please indicate well location X:

ADDITIONAL INFORMATION

If more than one screen,
show locations of each on sketch.