

DIKE  
L 77  
1-14-74

MISSISSIPPI  
BOARD OF WATER COMMISSIONERS  
416 North State Street  
Jackson, Mississippi 39201

CODED

WATER WELL DRILLERS LOG

Jan 14 1974 Chester Keener Pike  
date well completed firm name county well located

LANDOWNER: Ted Fosterberry  
Rt 4, Magnolia  
(mailing address)


WELL LOCATION:  
sec 3 T 1 N R 8 E  
4 miles NW of Boomers  
(distance) (direction) (nearest town)

WELL PURPOSE: Sanitary  
(home, irrigation, municipal, industrial)

WELL COMPLETION DATA:  
(1) diameter (inches) 4"  
(2) total depth (feet) 134  
(3) static water level (feet) 60 below above top of ground.  
(4) casing Plast bottom  
(material) (depth)  
(size) If telescope see back.  
(5) screen 6' 132'  
(length) (depth to top)  
4" Plast  
(size) (material)  
(6) pump Brooks  
(HP) (yield gpm)  
3/4 HP  
(type power)  
(7) electric log No  
(yes or no)  
(organization running log)  
(8) how well bottom plugged  
wooden plug

| description of formations encountered | from | to  |
|---------------------------------------|------|-----|
| Red clay                              | 0    | 17  |
| Red sand                              | 17   | 63  |
| Sand & gravel                         | 63   | 86  |
| Sabbaly                               | 86   | 92  |
| Red gravel                            | 92   | 96  |
| Sabbaly & chalk                       | 96   | 128 |
| Coarse sand - small pea gravel        | 128  | 134 |


CODED

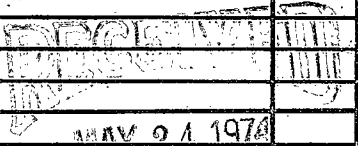

DRILLERS REMARKS:  
Plast supply water

If well telescopes please sketch and show depths.

GROUND LEVEL

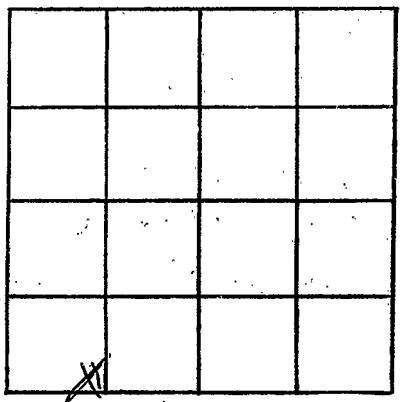

SECTION 3

Please indicate well location X.

ADDITIONAL INFORMATION

Lined area for additional information, consisting of approximately 25 horizontal lines.

If more than one screen, show locations of each on sketch.