


PIKE  
L 78  
1-8-74

MISSISSIPPI  
BOARD OF WATER COMMISSIONERS  
416 North State Street  
Jackson, Mississippi 39201

CODED


WATER WELL DRILLERS LOG

Jan 8 1974 Chester Keene Pike  
 (date well completed) (firm name) (county well located)

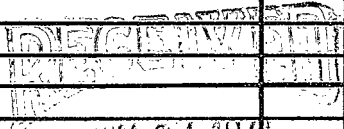LANDOWNER: <u>Herbert Stuckland Osyka, Miss -</u> (mailing address)	description of formations encountered	from	to
WELL LOCATION: sec. <u>3</u> T <u>1</u> N R <u>4</u> E <u>3/4</u> miles <u>NW</u> of <u>Progers</u> (distance) (direction) (nearest town)	<u>Red clay</u> <u>Clay &amp; gravel</u> <u>Sand &amp; gravel</u> <u>Slightly</u> <u>gravel</u>	<u>0</u> <u>8</u> <u>24</u> <u>38</u> <u>56</u>	<u>8</u> <u>24</u> <u>38</u> <u>56</u> <u>64</u>
WELL PURPOSE: <u>Head start school</u> (home, irrigation, municipal, industrial)	<p>CODED</p>  <p>MAY 21 1974</p>		
WELL COMPLETION DATA: (1) diameter (inches) <u>4"</u> (2) total depth (feet) <u>64</u> (3) static water level (feet) <u>45</u> below above top of ground. (4) casing <u>Plastic</u> <u>Bottom</u> (material) (depth) (size) If telescope see back. (5) screen <u>6"</u> <u>54'</u> (length) (depth to top) <u>4"</u> <u>Plastic</u> (size) (material) (6) pump <u>1/2 hp</u> <u>6</u> (HP) (yield gpm) <u>Elect</u> (type power) (7) electric log <u>NO</u> (yes or no) (organization running log) (8) how well bottom plugged <u>wood plug</u>			
DRILLERS REMARKS: <u>New location</u>			

If well telescopes please sketch and show depths.

GROUND LEVEL

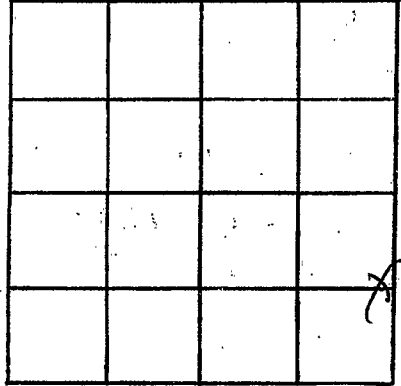

SECTION 3

Please indicate well location X.

ADDITIONAL INFORMATION

If more than one screen, show locations of each on sketch.