

PIKE
L 79
5-23-74

MISSISSIPPI
BOARD OF WATER COMMISSIONERS
416 North State Street
Jackson, Mississippi 39201

CODED

WATER WELL DRILLERS LOG

5/23 1974 *J. T. G. ...* *Pike*
date well completed firm name county well located

LANDOWNER: *CLAYTON GIVINS*

Osyka

(mailing address)

description of formations encountered	from	to
Red clay	0	20
Red clay	20	40
Red clay	40	60
Red clay Sand & GRAVEL	60	80
Sand & GRAVEL	80	100

WELL LOCATION:

sec 25 T 1 N R 5 E
2 miles W of Progers
(distance) (direction) (nearest town)

WELL PURPOSE:
(home, irrigation, municipal, industrial)

CODED

WELL COMPLETION DATA:


- (1) diameter (inches) 4
- (2) total depth (feet) 100
- (3) static water level (feet) 60 below/above top of ground.
- (4) casing pl 94
(material) (depth)
- if telescope see back.
(size)
- (5) screen 6 94
(length) (depth to top)
- 4 pl
(size) (material)
- (6) pump
(HP) (yield gpm)
- (type power)
- (7) electric log
(yes or no)
- (organization running log)
- (8) how well bottom plugged wood

DRILLERS REMARKS:

RECEIVED
JUL 11 1974

If well telescopes please
sketch and show depths.

GROUND LEVEL

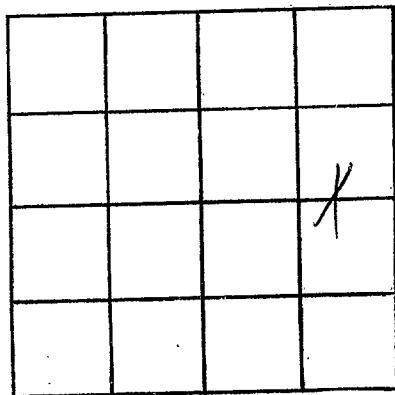

SECTION 27

Please indicate well location X.

ADDITIONAL INFORMATION

If more than one screen,
show locations of each on sketch.