

PIKE
L 80
C-11-74

MISSISSIPPI
BOARD OF WATER COMMISSIONERS
416 North State Street
Jackson, Mississippi 39201

CODED

WATER WELL DRILLERS LOG

6-11-74 date well completed 24 Fitzsimmons & Co. firm name Pike county well located

LANDOWNER:
Eugene Wallace
R.R. Magnolia
(mailing address)

description of formations encountered	from	to
Red clay	0	20
Red clay	20	143
Coarse sand gravel	143	155

WELL LOCATION:
sec. 18 T-10 N R-8 E
7 miles SSE of Magnolia
(distance) (direction) (nearest town)

WELL PURPOSE: None
(home, irrigation, municipal, industrial)

- WELL COMPLETION DATA:
- (1) diameter (inches) 4
 - (2) total depth (feet) 153
 - (3) static water level (feet) 85 below top of ground.
 - (4) casing Plastic, 147,
(material) (depth)
4 if telescope see back.
(size)
 - (5) screen 8, 147
(length) (depth to top)
4, Plastic
(size) (material)
 - (6) pump 1/2, 10
(HP) (yield gpm)
Electric
(type power)
 - (7) electric log No
(yes or no)
(organization running log)
 - (8) how well bottom plugged Sand block


CODED

REGISTERED
MAY 10 1974

DRILLERS REMARKS:

If well telescopes please sketch and show depths.

GROUND LEVEL

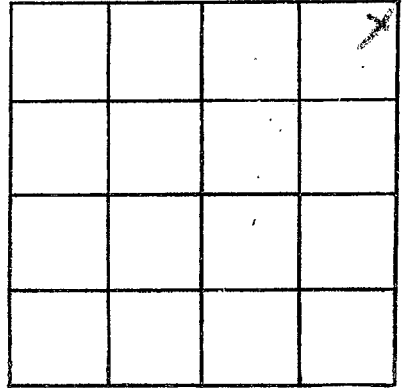

SECTION 19

Please indicate well location X.

ADDITIONAL INFORMATION

If more than one screen,
show locations of each on sketch.