

PIKE
L 81
8/74

MISSISSIPPI
BOARD OF WATER COMMISSIONERS
416 North State Street
Jackson, Mississippi 39201

CODED

WATER WELL DRILLERS LOG

date well completed 19 8/74 Earles, Stapp, Wells Well firm name Pike county well located

LANDOWNER: Curtis T. Norris

description of formations encountered

from

to

P.O. 882

McComb, Mississippi
(mailing address)

top soil 0 2

chalk 3 40

WELL LOCATION:

sec. 22 T 1 N R 8 E
12 miles W of Osprey
(distance) (direction) (nearest town)

sandy gravel 41 60

WELL PURPOSE: home
(home, irrigation, municipal, industrial)

WELL COMPLETION DATA:

(1) diameter (inches) 4"

(2) total depth (feet) 60 ft.

(3) static water level (feet) 40 below above top of ground.

(4) casing 4" 50'
(material) (depth)

4" if telescope see back.
(size)

(5) screen 10' 50'
(length) (depth to top)

4" plastic
(size) (material)

(6) pump _____ (HP) _____ (yield gpm)

_____ (type power)

(7) electric log _____ (yes or no)

_____ (organization running log)

(8) how well bottom plugged B.W.O.

CODED


RECEIVED
AUG 5 1974

DRILLERS REMARKS:
Close Drilling

MISS. BD. OF WATER COMMISSIONERS

If well telescopes please sketch and show depths.

GROUND LEVEL

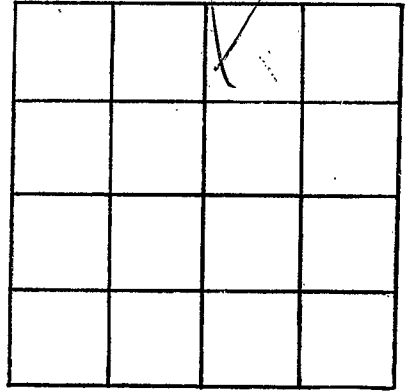

SECTION _____

Please indicate well location X.

ADDITIONAL INFORMATION

If more than one screen,
show locations of each on sketch.