

PRICE
L82
8-2-74

MISSISSIPPI
 BOARD OF WATER COMMISSIONERS
 416 North State Street
 Jackson, Mississippi 39201

CODED

WATER WELL DRILLERS LOG

8-2 1974 Flycatcher Sewer Pipe
 date well completed firm name county well located

LANDOWNER:

Bobby Rhodes

RR Memphis miss
 (mailing address)

WELL LOCATION:

sec. 6 T. 1 N. R. 8 E.
7 miles S of Memphis
 (distance) (direction) (nearest town)

WELL PURPOSE: Home
 (home, irrigation, municipal, industrial)

WELL COMPLETION DATA:

- (1) diameter (inches) 4
- (2) total depth (feet) 138
- (3) static water level (feet) 65 below above top of ground.
- (4) casing plastic, 130,
 (material) (depth)
4 if telescope see back.
 (size)
- (5) screen 8, 130
 (length) (depth to top)
4, plastic
 (size) (material)
- (6) pump 1/2 10
 (HP) (yield gpm)
Elm
 (type power)
- (7) electric log N
 (yes or no)
 (organization running log)
- (8) how well bottom plugged Sand plug

description of formations encountered

from to


<u>Red clay</u>	<u>0</u>	<u>20</u>
<u>Red sand</u>	<u>20</u>	<u>100</u>
<u>Red gravel</u>	<u>100</u>	<u>125</u>
<u>Coarse sand & gravel</u>	<u>125</u>	<u>138</u>

DRILLERS REMARKS:

REGISTERED
 AUG 26 1974
 MISS. Bd. OF WATER COMMISSIONERS

If well telescopes please sketch and show depths.

GROUND LEVEL

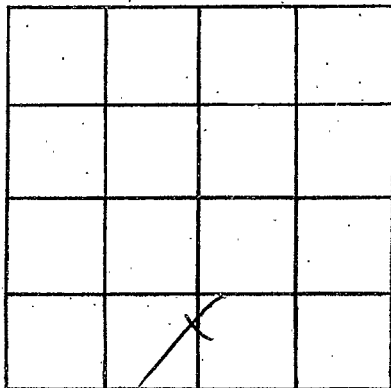

SECTION 6

Please indicate well location X.

ADDITIONAL INFORMATION

If more than one screen,
show locations of each on sketch.