

PIKE
L 83
8-14-74

MISSISSIPPI
BOARD OF WATER COMMISSIONERS
416 North State Street
Jackson, Mississippi 39201

CODED

WATER WELL DRILLERS LOG

Aug 14 1974 date well completed
Chester Keener firm name
Pike county well located

LANDOWNER: Pharoah Taylor
Rt 4 Magnolia (mailing address)

description of formations encountered	from	to
Sandy clay	0	26
sand & gravel	26	56
fruit-lobbolly	56	135
Red gravel & sand	135	144

WELL LOCATION:
sec 11 T 1 N R 4 E
3 NW miles of Progress (nearest town)

WELL PURPOSE: Home (home, irrigation, municipal, industrial)

- WELL COMPLETION DATA:
- (1) diameter (inches) 4"
 - (2) total depth (feet) 144
 - (3) static water level (feet) 50 below top of ground
 - (4) casing (material) Plast (depth) bottom
 - (5) screen (length) 6' (depth to top) 4'
 - (6) pump (HP) 1/2 HP (yield gpm) 6 gpm
 - (7) electric log (yes or no) No

(organization running log)


(8) how well bottom plugged
wooden plug

DRILLERS REMARKS:
New location

RECEIVED
OCT 21 1974

If well telescopes please sketch and show depths.

GROUND LEVEL

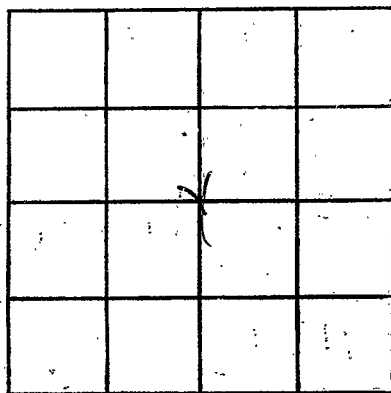

SECTION 11

Please indicate well location X.

ADDITIONAL INFORMATION

If more than one screen, show locations of each on sketch.