

PIKE  
L 84  
11-26-74

MISSISSIPPI  
BOARD OF WATER COMMISSIONERS  
416 North State Street  
Jackson, Mississippi 39201

CODED

WATER WELL DRILLERS LOG

11-26 1974 *Fitzgerald Well Serv* *Pike*  
date well completed firm name county well located

LANDOWNER:  
*Paul Brumfield*  
*P.R. Dasker*  
(mailing address)

description of formations encountered	from	to
<i>red clay</i>	<i>0</i>	<i>20</i>
<i>red sand</i>	<i>20</i>	<i>103</i>
<i>orange sand &amp; gravel</i>	<i>103</i>	<i>115</i>

WELL LOCATION:  
sec. *35* T. *1* N. R. *8* E.  
*6* miles *E* of *Osyka*  
(distance) (direction) (nearest town)

WELL PURPOSE: *Home*  
(home, irrigation, municipal, industrial)

- WELL COMPLETION DATA:
- (1) diameter (inches) *4*
  - (2) total depth (feet) *115*
  - (3) static water level (feet) *95* below top of ground.
  - (4) casing *plastic*, *107*,  
(material) (depth)  
*4* If telescope see back.  
(size)
  - (5) screen *8*, *107*  
(length) (depth to top)  
*4*, *plastic*  
(size) (material)
  - (6) pump *1/2*, *10*  
(HP) (yield gpm)  
*alco*  
(type power)
  - (7) electric log *no*  
(yes or no)  
(organization running log)
  - (8) how well bottom plugged *sandshank*

CODED


MISSISSIPPI BOARD OF WATER COMMISSIONERS  
FEB 10 1975

MISS. BD. OF WATER COMMISSIONERS

DRILLERS REMARKS:

If well telescopes please sketch and show depths.

GROUND LEVEL

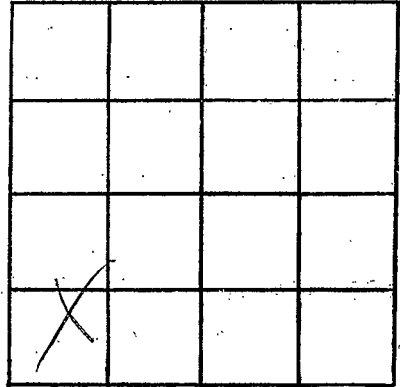

SECTION 30

Please indicate well location X.

ADDITIONAL INFORMATION

Multiple horizontal lines for additional information.

If more than one screen, show locations of each on sketch.