

PIKE
L 85
1-15-75

MISSISSIPPI
BOARD OF WATER COMMISSIONERS
416 North State Street
Jackson, Mississippi 39201

WATER WELL DRILLERS LOG

CODED

1-15

19 75 *Fitzgerald Redson Pike*

date well completed

firm name

county well located

LANDOWNER:	description of formations encountered	from	to
<i>Morris Cutler</i>			
<i>P.O. Magnolia</i> (mailing/address)	<i>Red clay</i>	<i>0</i>	<i>20</i>
	<i>Red sand + gravel</i>	<i>20</i>	<i>105</i>
	<i>Green sand + gravel</i>	<i>105</i>	<i>115</i>
WELL LOCATION:			
sec. <i>7</i> T. <i>1</i> N. R. <i>8</i> E			
<i>6</i> miles <i>S</i> of <i>Magnolia</i> (distance) (direction) (nearest town)			
WELL PURPOSE: <i>House</i> (home, irrigation, municipal, industrial)			
WELL COMPLETION DATA:			
(1) diameter (inches) <i>4</i>			
(2) total depth (feet) <i>115</i>			
(3) static water level (feet) <i>80</i> below top of ground.			
(4) casing <i>plastic, 107</i> (material) (depth)			
<i>4</i> (size) if telescope see back.			
(5) screen <i>8, 107</i> (length) (depth to top)			
<i>4</i> (size) <i>plastic</i> (material)			
(6) pump <i>1/2, 10</i> (HP) (yield gpm)			
<i>Electric</i> (type power)			
(7) electric log <i>No</i> (yes or no)			
<i>None</i> (organization running log)			
(8) how well bottom plugged <i>Small block</i>			
DRILLERS REMARKS:			

CODED


RECEIVED

FEB 10 1975

MISS BE

If well telescopes please sketch and show depths.

GROUND LEVEL

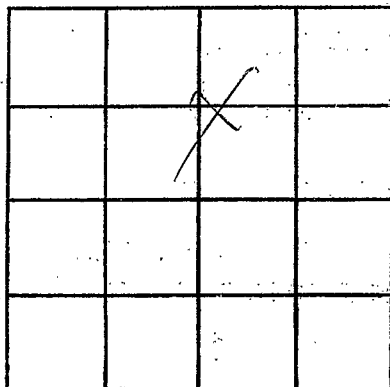

SECTION 7

Please indicate well location X₂.

ADDITIONAL INFORMATION

If more than one screen, show locations of each on sketch.