

PIKE
L88
11-13-74

MISSISSIPPI
BOARD OF WATER COMMISSIONERS
416 North State Street
Jackson, Mississippi 39201

CODED

WATER WELL DRILLERS LOG

Nov. 13 1974 Chet Thomas Pipe
date well completed firm name county well located

LANDOWNER:
Mrs. Mildred Barker
Rt 4 Magnolia
(mailing address)

description of formations encountered	from	to
<u>Red Clay</u>	<u>0</u>	<u>14</u>
<u>Red sand</u>	<u>14</u>	<u>45</u>
<u>sand + small gravel</u>	<u>45</u>	<u>60</u>
<u>lobbly</u>	<u>60</u>	<u>80</u>
<u>small pea gravel</u>	<u>80</u>	<u>98</u>
<u>Red sand</u>		

WELL LOCATION:
sec. 9 T 1 N R 8 E
1 1/2 miles West of Progers
(distance) (direction) (nearest town)

WELL PURPOSE: Home
(home, irrigation, municipal, industrial)

WELL COMPLETION DATA:
(1) diameter (inches) 4"
(2) total depth (feet) 98
(3) static water level (feet) 58 below top of ground.
(4) casing plastic, cotton
(material) (depth)
(size) if telescope see back.
(5) screen 6' 92'
(length) (depth to top)
1/2" plastic
(size) (material)
(6) pump 1/2 10
(HP) (yield gpm)
elect.
(type power)
(7) electric log no
(yes or no)
(organization running log)

(8) how well bottom plugged
Wooden plug


DRILLERS REMARKS:
new house site

RECEIVED
RECEIVED

MAR 31 1975

If well telescopes please sketch and show depths.

GROUND LEVEL

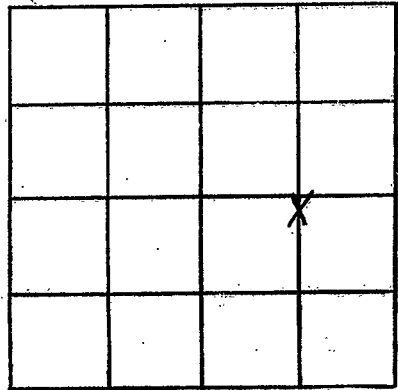

SECTION

9

Please indicate well location X.

ADDITIONAL INFORMATION

If more than one screen, show locations of each on sketch.