

PIKE  
L 89  
2-25-75

MISSISSIPPI  
BOARD OF WATER COMMISSIONERS  
416 North State Street  
Jackson, Mississippi 39201

CODE

WATER WELL DRILLERS LOG

2-25-75 date well completed      75 firm name *Fitzgerald Well Serv*      Pike county well located


LANDOWNER:	description of formations encountered	from	to
<i>Otis Kennedy</i>			
<i>B.R. Magnolia</i> (mailing address)	<i>Red clay</i> <i>Red sand</i> <i>Coarse sand &amp; gravel</i>	0 20 156	20 156 168
<b>WELL LOCATION:</b>			
sec. <u>4</u> T. <u>1</u> <u>N</u> R. <u>8</u> <u>E</u> <u>4</u> miles <u>SE</u> of <u>Magnolia</u> (distance) (direction) (nearest town)			
<b>WELL PURPOSE:</b> (home, irrigation, municipal, industrial) <u>Home</u>			
<b>WELL COMPLETION DATA:</b>			
(1) diameter (inches) <u>4</u>			
(2) total depth (feet) <u>168</u>			
(3) static water level (feet) <u>65</u> below above top of ground.			
(4) casing <u>plastic</u> , <u>160</u> , (material) (depth) <u>4</u> if telescope see back. (size)			
(5) screen <u>8</u> , <u>160</u> (length) (depth to top)			
(6) pump <u>4</u> , <u>plastic</u> (size) (material)			
(7) pump <u>1/2</u> , <u>10</u> (HP) (yield gpm)			
(8) electric log <u>electric</u> (type power)			
(7) electric log <u>no</u> (yes or no)			
(organization running log)			
(8) how well bottom plugged <u>sand shak</u>			
DRILLERS REMARKS:			

RECEIVED  
APR - 2 1975

MISS. Bd. OF WATER COMMISSIONERS

If well telescopes please sketch and show depths.

GROUND LEVEL

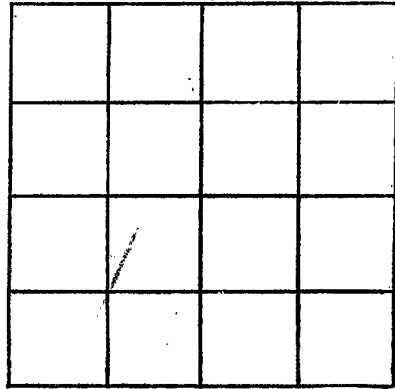

SECTION ~~1~~

Please indicate well location X.

ADDITIONAL INFORMATION

If more than one screen, show locations of each on sketch.