

Pike
L 90
7-24-75


MISSISSIPPI
 BOARD OF WATER COMMISSIONERS
 416 North State Street
 Jackson, Mississippi 39201

CODED

WATER WELL DRILLERS LOG

7-24 1975 Fitzgerald Well Co. Pike
 date well completed firm name county well located


LANDOWNER:	description of formations encountered	from	to
<u>Candrey Brothers</u>			
<u>R.R. Magnolia Miss.</u> (mailing address)	<u>Red clay</u>	<u>0</u>	<u>20</u>
	<u>Red sand</u>	<u>20</u>	<u>90</u>
	<u>Coarse sand</u>	<u>90</u>	<u>106</u>
WELL LOCATION:			
sec. <u>12</u> T. <u>1</u> N. <u>5</u> R. <u>8</u> E. <u>14th</u>			
<u>3</u> miles <u>NNW</u> of <u>Preyers</u> (distance) (direction) (nearest town)			
WELL PURPOSE: <u>home</u> (home, irrigation, municipal, industrial)			
WELL COMPLETION DATA:			
(1) diameter (inches) <u>4</u>			
(2) total depth (feet) <u>106</u>			
(3) static water level (feet) <u>78</u> below top of ground.			
(4) casing <u>plastic</u> , <u>98</u> (material) (depth)			
<u>4</u> if telescope see back. (size)			
(5) screen <u>8</u> , <u>98</u> (length) (depth to top)			
<u>4</u> , <u>plastic</u> (size) (material)			
(6) pump <u>1/2</u> , <u>10</u> (HP) (yield gpm)			
<u>elec</u> (type power)			
(7) electric log <u>no</u> (yes or no)			
(organization running log)			
(8) how well bottom plugged <u>Sand block</u>			
DRILLERS REMARKS:			

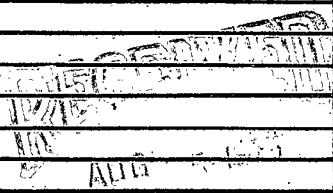

MISS. Bd. of WATER 62

If well telescopes please sketch and show depths.

GROUND LEVEL

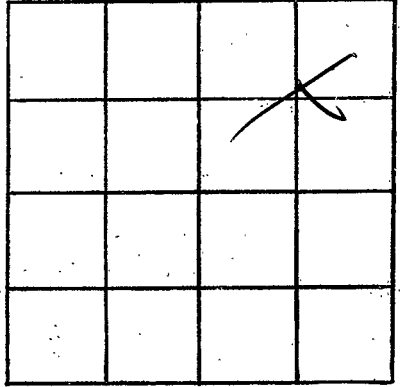

SECTION 12

Please indicate well location X.

ADDITIONAL INFORMATION

If more than one screen, show locations of each on sketch.