

Piloe
L 91
7-27-75

MISSISSIPPI
 BOARD OF WATER COMMISSIONERS
 416 North State Street
 Jackson, Mississippi 39201

CODED

WATER WELL DRILLERS LOG

9-27 1975 Floyd Well Serv Pike
 date well completed firm name county well located

LANDOWNER:	description of formations encountered	from	to
<u>Jerry Rhodes</u> <u>R.R. Magnolia</u> (mailing address)			
WELL LOCATION:			
sec. <u>2</u> T <u>1</u> N R <u>8</u> E 14H S			
<u>5</u> miles <u>NW</u> of <u>Pyrites</u> (distance) (direction) (nearest town)			
WELL PURPOSE: <u>Home</u> (home, irrigation, municipal, industrial)			
WELL COMPLETION DATA:			
(1) diameter (inches) <u>4</u>			
(2) total depth (feet) <u>151</u>			
(3) static water level (feet) <u>45</u> below top of ground.			
(4) casing <u>plastic</u> , <u>143</u> , (material) (depth) <u>4</u> if telescope see back. (size)			
(5) screen <u>8</u> , <u>143</u> (length) (depth to top) <u>4</u> , <u>plastic</u> (size) (material)			
(6) pump <u>1/2</u> , <u>10</u> (HP) (yield gpm) <u>clear</u> (type power)			
(7) electric log <u>no</u> (yes or no)			
(organization running log)			
(8) how well bottom plugged <u>Full</u>			
DRILLERS REMARKS:			


CODED

RECEIVED
 DEPT. OF WATER COMMISSIONERS
 JUNE 10 1975

MISSISSIPPI BOARD OF WATER COMMISSIONERS

If well telescopes please sketch and show depths.

GROUND LEVEL

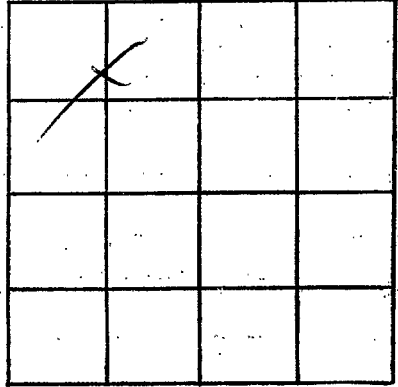

SECTION 2

Please indicate well location X.

ADDITIONAL INFORMATION

If more than one screen, show locations of each on sketch.