

PIKE
L 93
7-5-77

MISSISSIPPI
BOARD OF WATER COMMISSIONERS
416 North State Street
Jackson, Mississippi 39201

CODED

WATER WELL DRILLERS LOG

July 5 1977 Couington Pike
date well completed firm name county well located

LANDOWNER: En. Brumfield
Magnolia Miss

description of formations encountered	from	to
CLAY	0	24
SANDY CLAY	24	72
Red CLAY /	72	88
SAND /	88	96
CHALK + SAND	96	144
SAND + ROCKS	144	170

(mailing address)
WELL LOCATION:
sec. 22 T 1 N R 8 E
S E
_____ miles _____ of _____
(distance) (direction) (nearest town)

WELL PURPOSE: None
(home, irrigation, municipal, industrial)

WELL COMPLETION DATA:
(1) diameter (inches) 4
(2) total depth (feet) 170
(3) static water level (feet) 90 below above top of ground.
(4) casing Plastic 150
(material) (depth)
4 if telescope see back.
(size)
(5) screen 20' 150
(length) (depth to top)
4 Plastic
(size) (material)
(6) pump 5 50
(HP) (yield gpm)
Electric
(type power)
(7) electric log _____
(yes or no)

(organization running log)
(8) how well bottom plugged wood

CODED


RECEIVED
AUG 5 1977

DRILLERS REMARKS:

MISS. RD. OF WATER COMMISSIONERS

If well telescopes please sketch and show depths.

GROUND LEVEL

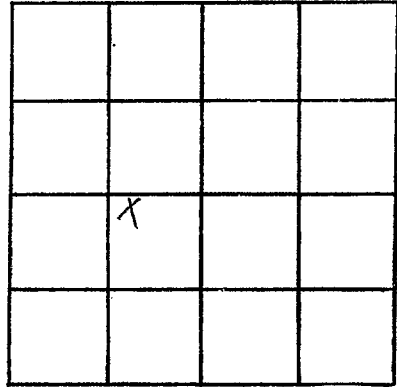

SECTION 23

Please indicate well location X.

ADDITIONAL INFORMATION

If more than one screen,
show locations of each on sketch.